IREDELL COUNTY HEALTH DEPARTMENT

STATESVILLE 704-878-5305 MOORESVILLE 704-664-5281

IMPROVEMENT PERMIT / AUTHORIZATION TO CONSTRUCT / OPERATION PERMIT / EXISTING SYSTEM INSPECTION

PERMIT# 092702 PIN# 4725 65 9796 DATE 12-28-00

OWNER OR CONTRACTOR DAVID MILLER PHONE: Business Home 924-9451

ADDRESS 174 W. IREDELL CIR, STATESVILLE, NC 28625

LOCATION NC 90 W, TR MONTICELLO AR, TL MEADOW LARK DR, TL ORIOLE COURT, LOT AT END ON RIGHT

SUBDIVISION AUDUBON ACRES BLOCK / SECTION LOT 29 LOT AREA 1.38 ACRES SITE CLASS PS DESIGN FLOW 360 L.T.A.R. 0.25 GPD/FT²

Septic Tank: 1000 Gallons; STB 312 Date 10-9-00
Pump Tank: Gallons; PT Date
Pump Make: Model Serial No.
Nitrification Field: No Fields 1 Square Feet EQ. TO 1440 Linear Feet 240
No Lines SIX Trench Width 24" Max Trench Bottom Depth 36" Gravel Depth SAND 6"

☑ New System ☐ Repair System Type: I, II, (III), V, VI
System Description: 50% REDUCTION GRAVITY
Repair System Description: 50% REDUCTION PUMP
Maintenance Agreement Required: ☐ Yes ☑ No


☑ House/Mod. Home No. Bedrooms 3
☐ Mobile Home No. Bathrooms 3
☐ Business No. Employees
☐ Other
☐ Slab ☐ Crawl Space ☑ Basement w/plumbing ☐ Basement wo/plumbing

Water Supply: ☐ Individual ☑ Public ☐ Community


Comments/Conditions: ① INSTALL 54 PPBPS PANELS IN SIX EQUAL LENGTH LINES. ② USE ONE FLOW DIVIDER TEE FOR EQUAL DISTRIBUTION INTO TWO SETS OF DROP BOXES. ③ INSTALL SUBSURFACE INTERCEPT DRAINAGE DITCH AS SHOWN BEGINNING 48 INCHES DEEP.

Comments/Conditions: – Zabel Filter Installed
– Septic Tank Riser Installed

INITIAL SITE SKETCH

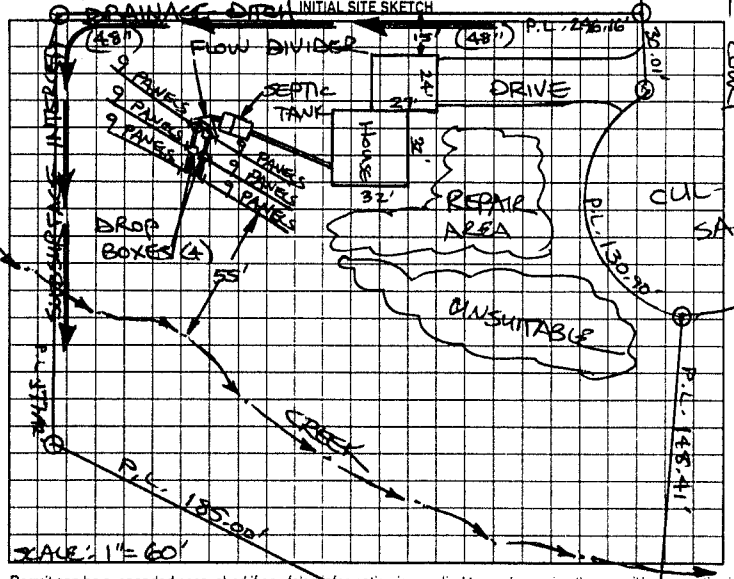

AS BUILT SKETCH

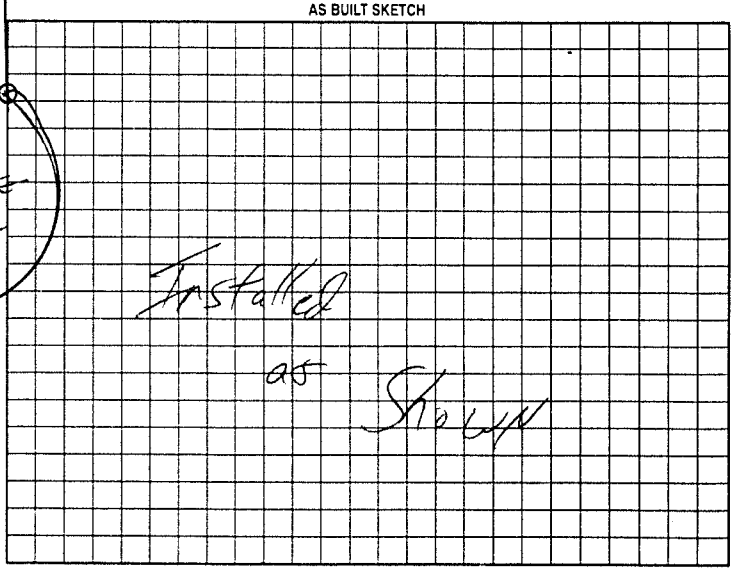

Permit can be suspended or revoked if any false information is supplied toward securing the permit/any unauthorized changes are made to the site/any unauthorized changes are made in the installation of the system. Improvement Permit with plat valid without expiration. Improvement Permit with site plan valid for sixty months. Authorization to Construct is valid for a period equal to that of Improvement Permit – not to exceed sixty months.

Signed: David A. Miller date 1-02-01 Installed by: James Bramlett / Statesville Grading

Improvement Permit by: STEVE HEDRICK date 12-28-00 Operation Permit by: [signature] date 9/29/0

Authorization to Construct by: STEVE HEDRICK date 12-28-00 Existing System Inspection by: date

HEALTH DEPT. COPY: WHITE OWNER COPY (FINAL): YELLOW OWNER COPY (INITIAL): PINK