IREDELL COUNTY HEALTH DEPARTMENT

4725-68-5307 $130 CI

STATESVILLE 704-878-5305 MOORESVILLE 704-664-5281 704-872-3443

IMPROVEMENT PERMIT / AUTHORIZATION TO CONSTRUCT / OPERATION PERMIT / EXISTING SYSTEM INSPECTION

PERMIT# 12462 PIN# 4725 68 3576 4725684487 DATE 2/25/05

OWNER OR CONTRACTOR O'BRIEN BUILDERS PHONE: Business Home

ADDRESS 310 TREE BARK STATESVILLE, NC 28625

LOCATION I-77 115(N) - TL SCOTTS CREEK - TL MILLER FARM - TL DOVE MEADOW - ON LT CORNER

SUBDIVISION DOVE MEADOWS BLOCK / SECTION 1 LOT 4 LOT AREA 1.046AC SITE CLASS PS DESIGN FLOW 360GPD L.T.A.R. 300/NA

Septic Tank: 1000 Gallons; STB 625 Date 6-2-05

Pump Tank: 1000 Gallons; PT 302 Date 6-23-05

Pump Make: ZOELLER Model 152 Serial No.

Nitrification Field: No Fields 1 Square Feet 900 Linear Feet 300

No. Lines 5@60' Trench Width 36" Max Trench Bottom Depth 18" Gravel Depth N/A

☑ New System ☐ Repair System Type: I, II, III, IV, V, VI

System Description: PUMP 25% REDUCTION

Repair System Description: CPP

Maintenance Agreement Required: ☐ Yes ☑ No

☑ House/Mod. Home No. Bedrooms 3

☐ Mobile Home No. Bathrooms 3

☐ Business No. Employees

☐ Other

☐ Slab ☑ Crawl Space ☐ Basement w/plumbing ☐ Basement wo/plumbing

Water Supply: ☐ Individual ☑ Public ☐ Community


Comments:/Conditions:

Comments:/Conditions: POLYLOK FILTER & MARKER


BUILDER SHOWED ME P/L. SYSTEM IS 10' OFF W HOUSE SHOWN. LC V'D LINES & TANKS, 9-8-05

V'D PRESSURE LC 9-8-05

INITIAL SITE SKETCH

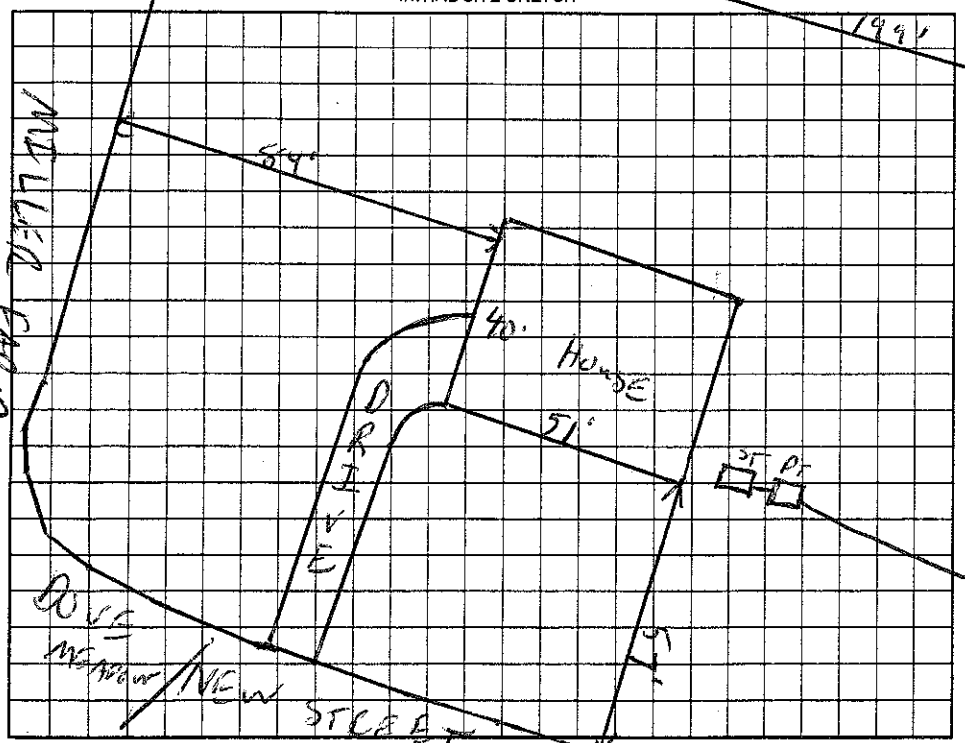

AS BUILT SKETCH 1" = 40' 133'

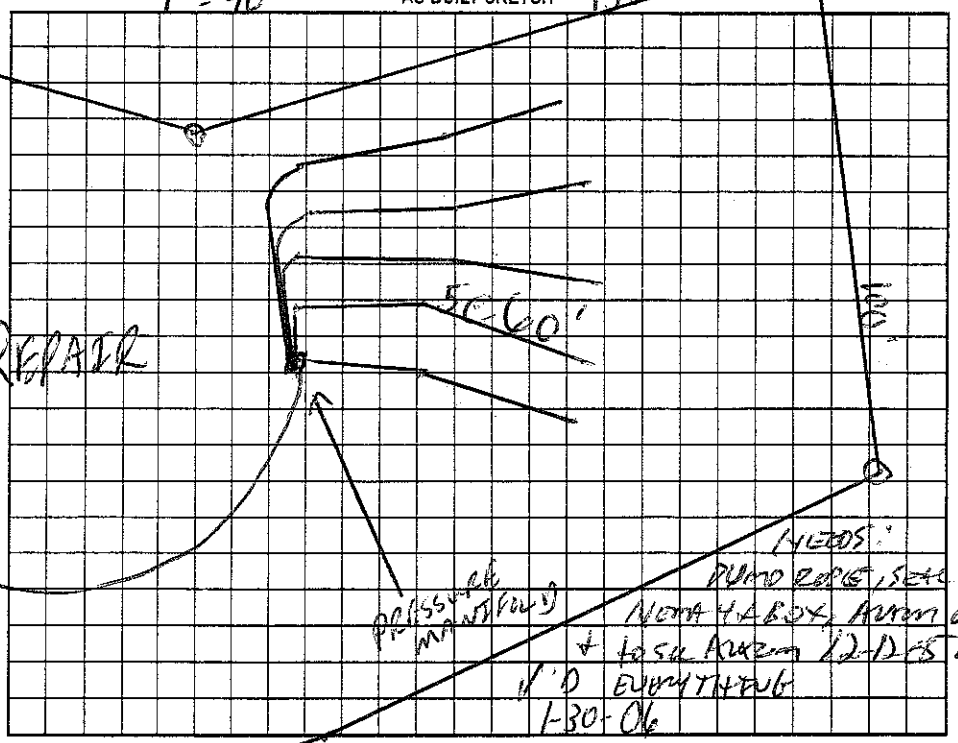

Permit can be suspended or revoked if any false information is supplied toward securing the permit/any unauthorized changes are made to the site/any unauthorized changes are made in the installation of the system. Improvement Permit with plat valid without expiration. Improvement Permit with site plan valid for sixty months. Authorization to Construct is valid for a period equal to that of Improvement Permit – not to exceed sixty months.

Signed: date

Improvement Permit by: date 2/25/05

Authorization to Construct by: date 2/25/05

Installed by: DALUY MADISON

Operation Permit by: date 1-30-06

Existing System Inspection by: date

HEALTH DEPT. COPY: WHITE OWNER COPY (FINAL): YELLOW OWNER COPY (INITIAL): PINK