IREDELL COUNTY HEALTH DEPARTMENT

Statesville Phone TR 3-7271 Mooresville Phone MO 3-1271

PERMIT TO INSTALL SEPTIC TANK

Permit NO. _____ Permit Date April 19 1963

Owner Bell Construction Co. Address Rte 8 City

Installed By C Hoke Address R7-


Location of Property out 90 Past I 40 - Right on service Rd. go 3 block on left, overlooking I 40.

Tank		Capacity		Length of Lines		Fixtures	
Block	( )	800	( )	150'	( )	No. of Baths	(3) Stool
Precast	(✓)	900	( )	175'	( )	Dishwasher	( )
		1000	(✓)	200'	( )	Garbage Grdr.	( )
		1100	( )	225'	(✓)	Auto-Washer	( )
		1200	( )	250'	( )	Other	_____
		Other	_____	Other	_____		

NOTIFY HEALTH DEPARTMENT AT LEAST EIGHT HOURS BEFORE TANK IS TO BE INSPECTED.

Final Inspection 4-19 1963 Approved ( ) Disapproved ( )

Remarks garage & servic Area. ditch 7½ ft wide due to limited area to put due to parking

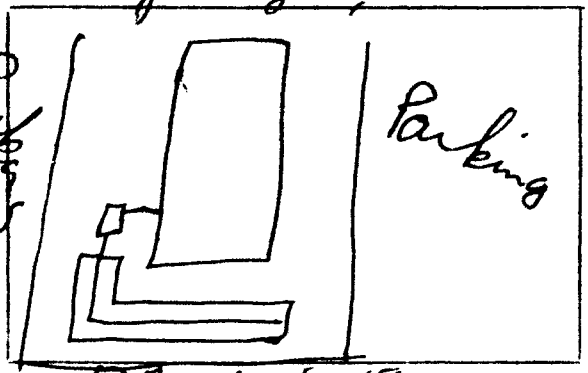

Sketch of Installation

Rt.

Sanitarian