77152

IREDELL COUNTY HEALTH DEPARTMENT

STATESVILLE 704-878-5305 MOORESVILLE 704-664-5281

IMPROVEMENT PERMIT / AUTHORIZATION TO CONSTRUCT / OPERATION PERMIT / EXISTING SYSTEM INSPECTION

PERMIT# STATESVILLE PIN# 4725 73 0977 DATE 9-3-98

OWNER OR CONTRACTOR DONALD KEITH ZIGLAR PHONE: Business Home 872-8475

ADDRESS 131 MONTE VISTA DRIVE, STATESVILLE, NC 28625

LOCATION NC 90 WEST, TR MONTICELLO DR, TR MONTE VISTA DR, TR FRYE LANE

SUBDIVISION MONTICELLO HEIGHTS BLOCK / SECTION LOT 44-49 LOT AREA 140' X 200' SITE CLASS PS DESIGN FLOW 360 L.T.A.R. 0.30 GPD/FT²

Septic Tank: 1000 Gallons; STB 825 Date 11-8-98
Pump Tank: Gallons; PT Date
Pump Make: Model Serial No.
Nitrification Field: No Fields 1 Square Feet SQ FT 1200 Linear Feet 300
No Lines FOUR Trench Width 36" Max Trench Bottom Depth 36" ~~Gravel~~ Depth SAND

☑ New System ☐ Repair System Type: I, II, (III), IV, V, VI
System Description: 25% REDUCTION GRAV
Repair System Description: 25% REDUCTION PUMP
Maintenance Agreement Required: ☐ Yes ☑ No

☑ House/Mod. Home No. Bedrooms 3
☐ Mobile Home No. Bathrooms 2
☐ Business No. Employees
☐ Other
☐ Slab ☑ Crawl Space ☐ Basement w/plumbing ☐ Basement wo/plumbing


Water Supply: ☐ Individual ☑ Public ☐ Community

Comments:/Conditions: INSTALL 300 FEET OF 25% REDUCTION SYSTEM IN FOUR LINES AS SHOWN, ON CONTOUR.


Comments:/Conditions: SYSTEM ALTERED BY PRIOR AGREEMENT W/ HEALTH DEPT. AS SHOWN BELOW

SCALE: 1" = 40'

INITIAL SITE SKETCH

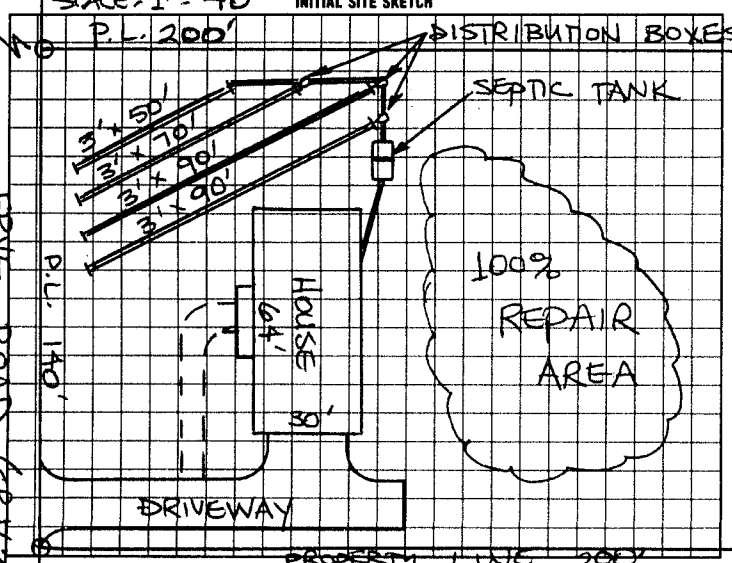

AS BUILT SKETCH

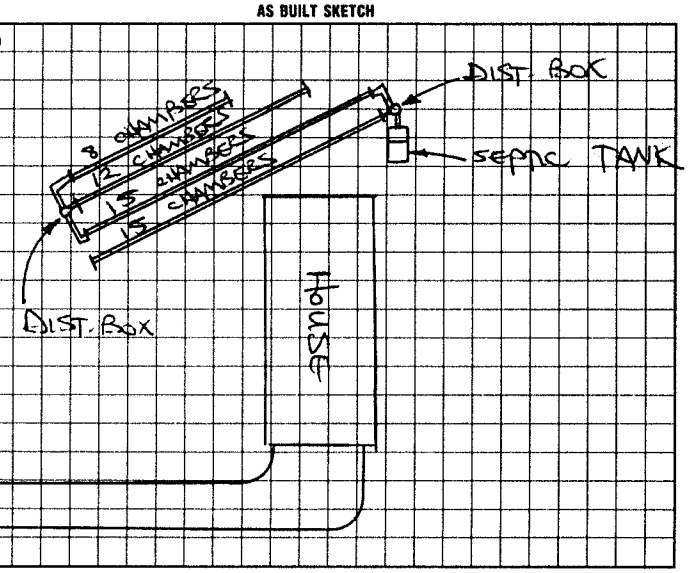

I understand that this permit can be suspended or revoked if any false information is supplied toward securing the permit/any unauthorized changes are made to the site/any unauthorized changes are made in the installation of the system. Improvement Permit with plat valid without expiration. Improvement Permit with site plan valid for sixty months. Authorization to Construct is valid for a period equal to that of Improvement Permit – not to exceed sixty months.

Signed: date

Improvement Permit by: STEVE HEDRICK date 9-3-98

Authorization to Construct by: STEVE HEDRICK date 9-3-98

Installed by: WAYNE CLONTZ

Operation Permit by: STEVE HEDRICK date 1-14-99

Existing System Inspection by: date

HEALTH DEPT. COPY: WHITE INSPECTION COPY (FINAL): GREEN OWNER COPY (FINAL): YELLOW INSPECTION COPY (INITIAL): PINK OWNER COPY (INITIAL): GOLD