Permit #110621

IREDELL COUNTY HEALTH DEPARTMENT

STATESVILLE 704-878-5305 MOORESVILLE 704-664-5281

IMPROVEMENT PERMIT / AUTHORIZATION TO CONSTRUCT / OPERATION PERMIT / EXISTING SYSTEM INSPECTION

PERMIT# City of Statesville PIN# 4725-73-2206 DATE 12/10/02

OWNER OR CONTRACTOR Dixie Land INC PHONE: Business (704) 876-6162 Home —

ADDRESS 823 Jennings Road Statesville N.C. 28625

LOCATION Hwy 115 N, (1) on old Wilkesboro Rd, (2) Monticello Dr. (3) Monte Vista (4) on Bass Lane, Lot on Left

SUBDIVISION Monticello Heights BLOCK / SECTION — LOT 37 LOT AREA .46 Acres SITE CLASS. V5 DESIGN FLOW 360 L.T.A.R. .25

Septic Tank: 4000 Gallons; STB — Date —

Pump Tank: — Gallons; PT — Date —

Pump Make: — Model — Serial No. —

Nitrification Field: No Fields 1 Square Feet Eqv. to 440 Linear Feet 360

No Lines 5 Trench Width 36" Max Trench Bottom Depth 36" Gravel Depth NA

☒ New System ☐ Repair System Type: I, II, (III), IV, V, VI

System Description: Gravity, 25% Reduction

Repair System Description: ~~Std~~ 50% Reduction

Maintenance Agreement Required: ☐ Yes ☒ No (LP panels)

☒ House/Mod. Home No. Bedrooms 3

☐ Mobile Home No. Bathrooms 2

☐ Business No. Employees —

☐ Other —

☐ Slab ☒ Crawl Space ☐ Basement w/plumbing ☐ Basement wo/plumbing

Water Supply: ☐ Individual ☒ Public ☐ Community


Comments/Conditions: (1) Install 25% Reduction System

(2) Maintain minimum 50ft From neighbor well


Comments/Conditions:

- Polylok filter Installed
- 58 Infi Hunter Chambers Installed

INITIAL SITE SKETCH

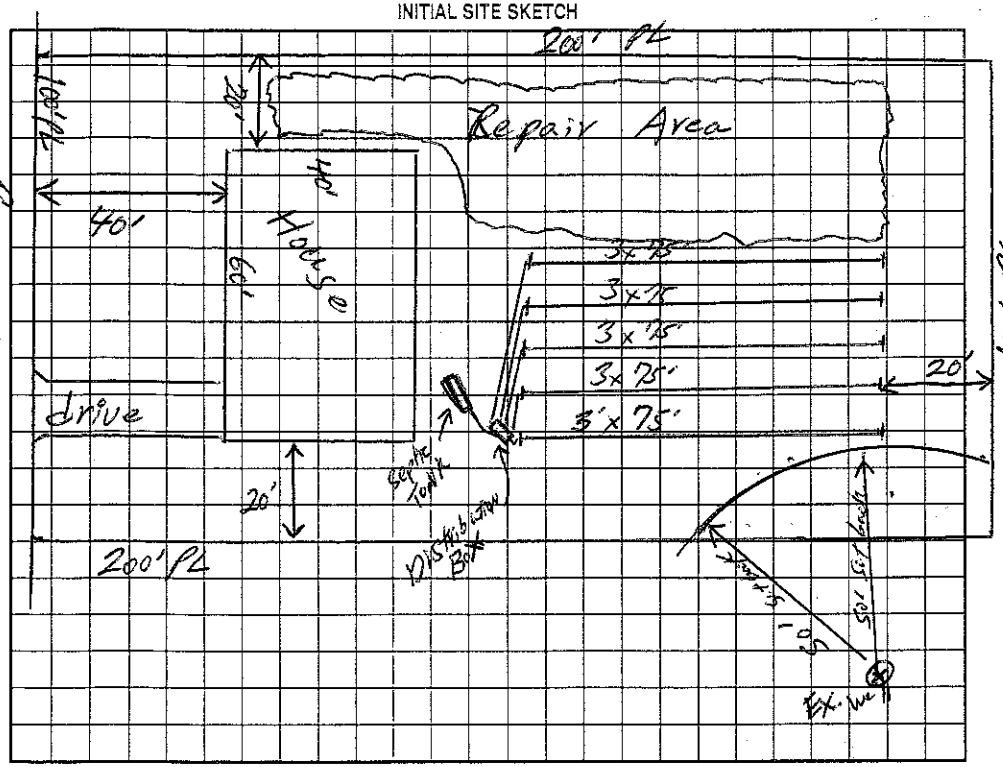

AS BUILT SKETCH

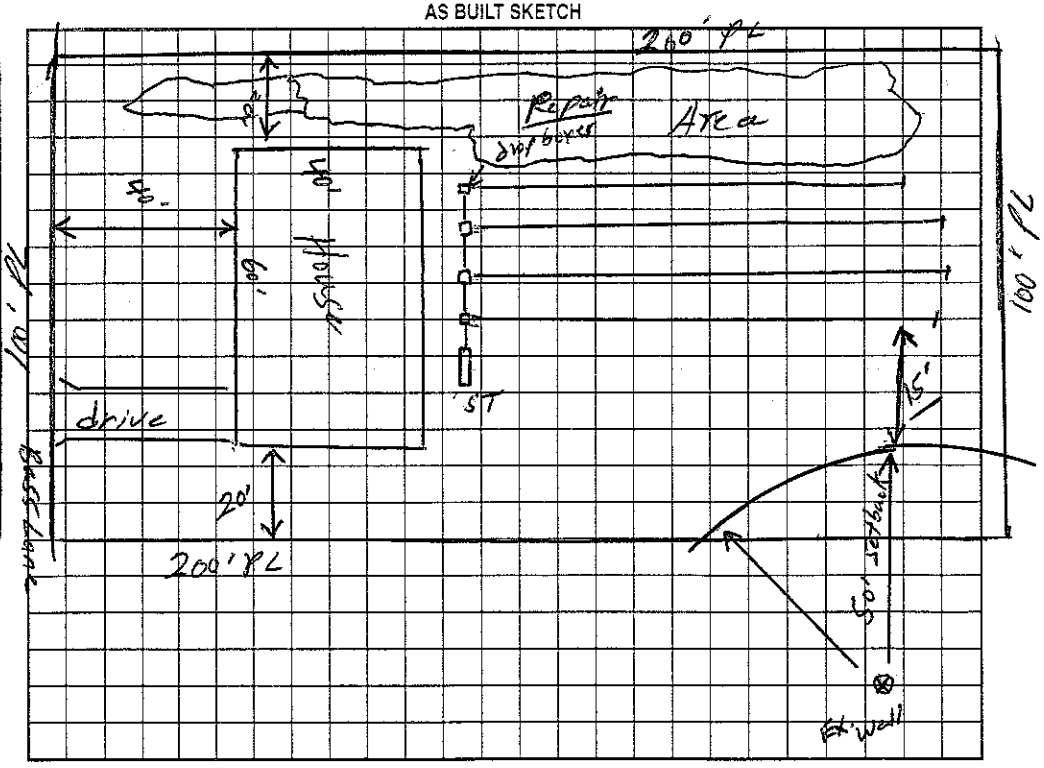

Permit can be suspended or revoked if any false information is supplied toward securing the permit/any unauthorized changes are made to the site/any unauthorized changes are made in the installation of the system. Improvement Permit with plat valid without expiration. Improvement Permit with site plan valid for sixty months. Authorization to Construct is valid for a period equal to that of Improvement Permit – not to exceed sixty months.

Signed: Regina K Cecil date 12/10/02 Installed by: Rowan Septic

Improvement Permit by: William O. Johnson date 12/10/02 Operation Permit by: William O. Johnson date 2/11/03

Authorization to Construct by: William O. Johnson date 12/10/02 Existing System Inspection by: — date —

HEALTH DEPT. COPY: WHITE OWNER COPY (FINAL): YELLOW OWNER COPY (INITIAL): PINK