IREDELL COUNTY HEALTH DEPARTMENT

Statesville Phone TR 3-7271 Mooresville Phone NO 3-1271

PERMIT TO INSTALL SEPTIC TANK

Permit No. _____ Permit Date Jan 31 19 67

Owner Ola Hefner Elder. Address City

Installed By C Hoke Address R7


Location of Property Monticello Hghts. S/D 3rd block on Corner.

Tank	Capacity	Length of Lines	Fixtures
Block ( )	1000 (✓)	225' ( )	No. of Baths (2)
Precast (✓)	1250 ( )	250' (✓)	Dishwasher ( )
	1500 ( )	Other 255	Garbage Grdr. ( )
	Other _____		Other _____

NOTIFY HEALTH DEPARTMENT AT LEAST EIGHT HOURS BEFORE TANK IS TO BE INSPECTED.

Final Inspection _____ 19__ Approved ( ) Disapproved ( )

Remarks well not down This date owner states not over 4 adults at any time. will sign release for all involed. to be rental house under his controll.

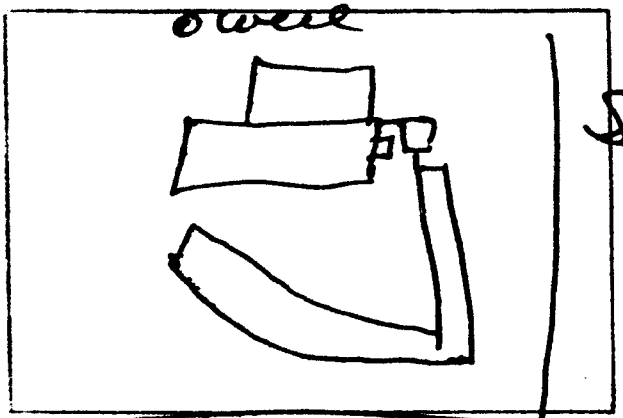

Sketch of Installation Sterl

Sanitarian