IREDELL COUNTY HEALTH DEPARTMENT

Statesville Office (704) 878-5305 Mooresville Office (704) 660-3625 PERMIT # 181749 BF

IMPROVEMENT PERMIT / AUTHORIZATION TO CONSTRUCT / OPERATION PERMIT / EXISTING SYSTEM

PIN # 4725737533

APPLICANT: Todd Austin APPLICANT ADDRESS: 161 Monte Vista Rd.

SITE ADDRESS: 161 Monte Vista Rd. PHONE: 704-903-8902 ALT. PHONE: N/A

SITE DIRECTIONS: Hwy 115 N TL old Wilkesboro Rd TL Monticello TL Monte Vista Rd.

SUBDIVISION: Monticello Heights SECTION: N/A LOT # 9-12 LOT AREA: 0.46 acres DESIGN FLOW: 360 gpd L.T.A.R.: 0.3

Septic Tank 1000 (gal) STB 1012-1000 Date 5-23-13
Pump Tank (gal) PT Date
Pump Make Model Serial #
Nitrification Fields 1 # Lines 4 Linear Ft: 304'
Trench Width 36" Max. Trench Bottom Depth 30" Gravel Depth N/A


☐ New System ☑ Repair ☐ Expansion System Type: I II ☒ IV V VI
System Description:
Repair System Description: 25% Reduction
Maintenance Agreement Required: ☐ YES ☒ NO
☒ GRAVITY ☐ PRESSURE

☑ Residence No. Bedrooms 3
☐ Business No. Persons
☐ Other No. Employees
☐ Slab ☐ Crawl Space
☑ Basement w/plumbing ☐ Basement w/o plumbing

Water Supply: ☐ Private ☑ Public ☐ Community

Comments / Conditions: Pump & crush existing septic tank. Set new Septic tank @ location shown below. Install a 25% Reduction system on contour with serial distribution.

INITIAL SITE SKETCH

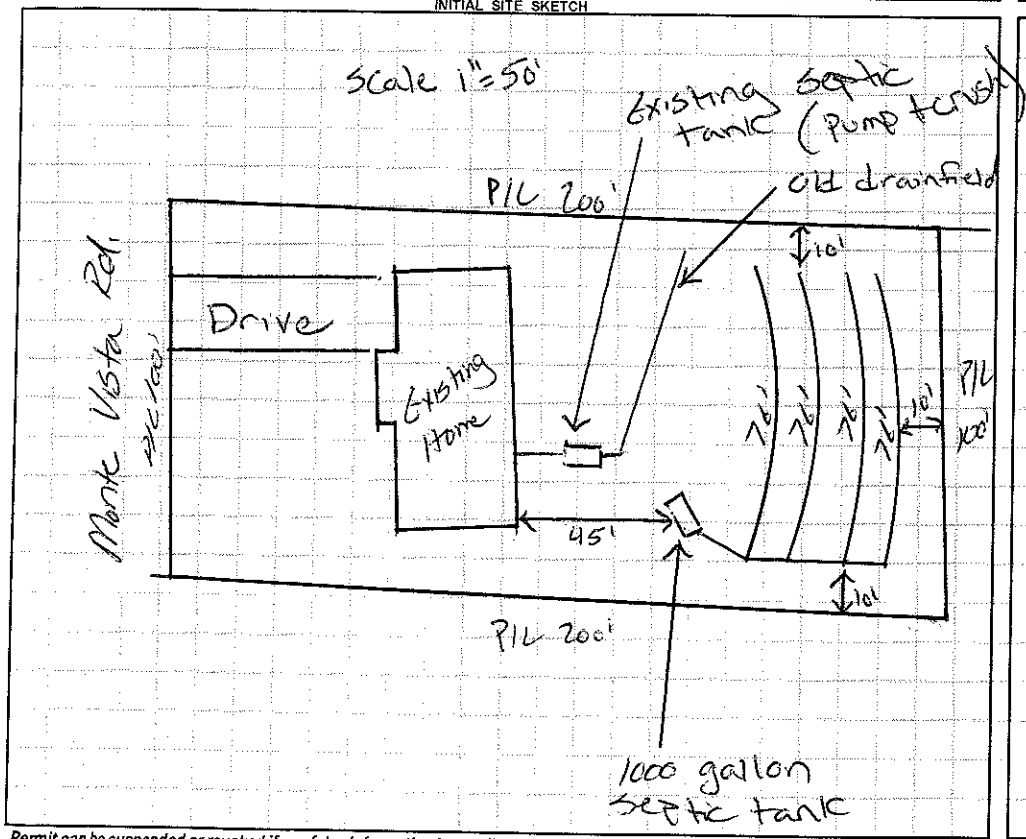

AS BUILT SKETCH

- Red Polylok filter installed
- 2" PVC Septic tank marker installed
- Quick 4 Chambers Installed
- Installed as drawn

Permit can be suspended or revoked if any false information is supplied toward securing the permit / any unauthorized changes are made to the site / any unauthorized changes are made in the installation of the system. **CONTACT A LOCATOR SERVICE PRIOR TO ANY EXCAVATION**

☑ **IMPROVEMENT PERMIT** *with plat valid without expiration.* ☐ **IMPROVEMENT PERMIT** *with site plan valid for 60 mos.* ☐ **AUTHORIZATION TO CONSTRUCT** *valid for period equal to IMPROVEMENT PERMIT--not to exceed 60 mo.*

Owner / Applicant Signature: Todd E. Austin Date: 11-12-13 Installed by: David Yountz

IMPROVEMENT PERMIT by: Justin Henderson Date: 11-8-13 OPERATION PERMIT by: Justin Henderson Date: 11-15-13

AUTHORIZATION TO CONSTRUCT by: Justin Henderson Date: 11-8-13 Existing System Inspected by: Date:

Health Dept. Copy - WHITE Applicant (Final Approval) - YELLOW Applicant (Conditional Approval) - PINK