IREDELL COUNTY HEALTH DEPARTMENT

STATESVILLE 704-878-5305 MOORESVILLE 704-664-5281

IMPROVEMENT PERMIT / CERTIFICATE OF COMPLETION / OPERATION PERMIT / EXISTING SYSTEM INSPECTION

PROPERTY DESCRIPTION NO. Statesville DATE 3-18-97 TAX MAP NO. 4725-73-7732 Watershed: ☐ Yes ☑ No

OWNER OR CONTRACTOR John King (RW. Nicholson cont.) PHONE: Business 876-4359 Home

ADDRESS 182 milestone Dr

LOCATION 90 W TR monticello Dr. TR montevista 1/4 mi left

SUBDIVISION Monticello Heights BLOCK / SECTION LOT 1 LOT AREA 100X200 SITE CLASS. PS DESIGN FLOW 360 L.T.A.R. .28

Septic Tank: 1000 Gallons; STB 1012 Date 6-14-97

Pump Tank: Gallons; PT Date

Pump Make: Model Serial No.

Nitrification Field: No Fields 1 Square Feet 960 Linear Feet 320

No Lines 4 Trench Width 36" Max Trench Bottom Depth 36" Gravel Depth

☑ New System ☐ Repair System Type: I, II, III, IV, V, VI

System Description: Gravity/Chambers

Repair System Description: Pump to Panels

Maintenance Agreement Required: ☐ Yes ☑ No

☐ Slab ☑ Crawl Space ☐ Basement w/plumbing ☐ Basement wo/plumbing

☑ House/Mod. Home No. Bedrooms 3

☐ Mobile Home No. Bathrooms 2

☐ Business No. Employees


☐ Other

Water Supply: ☐ Individual ☐ Community ☑ Public


Comments:

Comments:

INITIAL SITE SKETCH

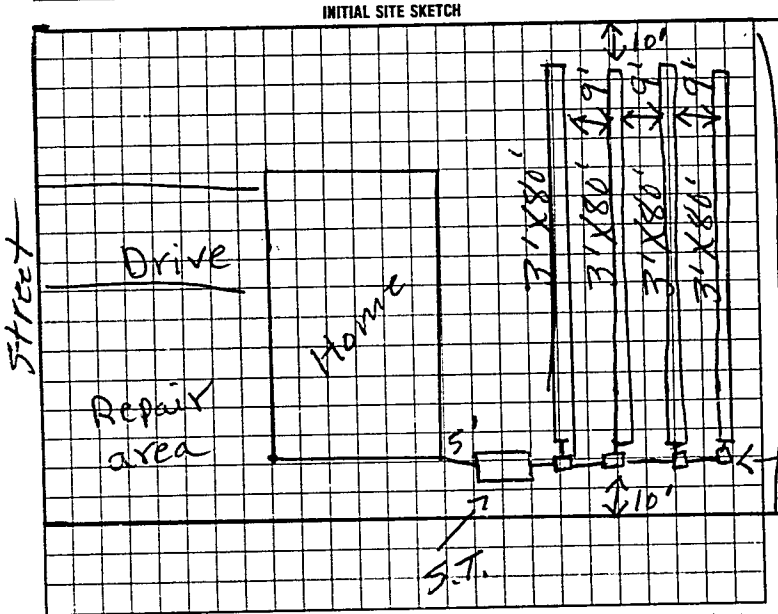

AS BUILT SKETCH

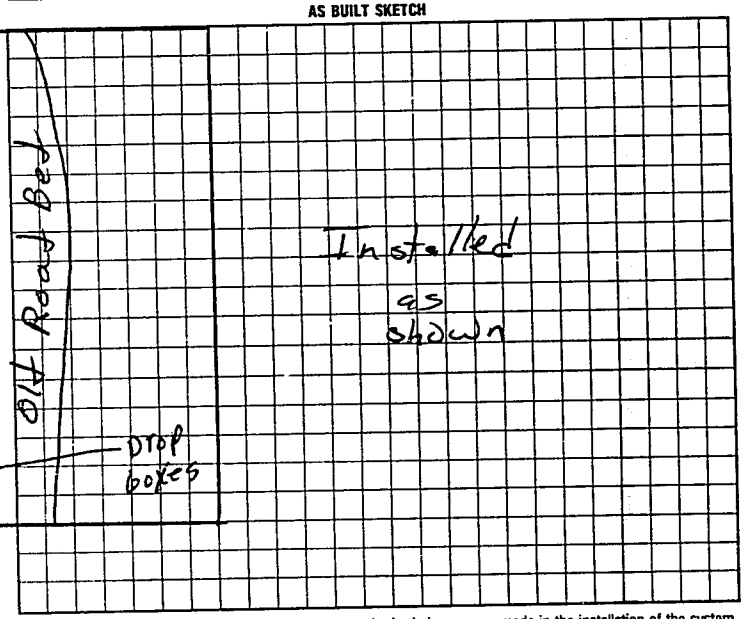

I understand that this permit can be suspended or revoked if any false information is supplied toward securing the permit/any unauthorized changes are made to the site/any unauthorized changes are made in the installation of the system. Improvement Permit is valid for 60 months from date of issuance.

Signed: RW Nicholson Inc

Improvement Permit by: F.C. Moore date 3-18-97

Authorization for Existing System Inspection by: F.C. moore date 3-18-97

Installed by: David Yountz

Certificate of Completion by: date

Operation Permit by: Mark C Ostby date 8-28-97

Authorization to Const. Expires 6 months from issue

HEALTH DEPT. COPY: WHITE INSPECTION COPY (FINAL) GREEN OWNER COPY (FINAL) YELLOW INSPECTION COPY (INITIAL) PINK OWNER COPY (INITIAL) GOLD

215100