IREDELL COUNTY HEALTH DEPARTMENT

STATESVILLE 704-878-5305 MOORESVILLE 704-664-5281

IMPROVEMENT PERMIT / AUTHORIZATION TO CONSTRUCT / OPERATION PERMIT / EXISTING SYSTEM INSPECTION

PERMIT# REPAIR PIN# 4725-74-4286 DATE 8-17-05

OWNER OR CONTRACTOR RHONDA JO ANN BURRELL PHONE: Business Home

ADDRESS 126 MONTE VISTA DRIVE, STATESVILLE

LOCATION NC 90 WEST, TR MONTICELLO DRIVE, TR MONTEVISTA DRIVE, 4TH LOT ON RIGHT AT #126

SUBDIVISION MONTICELLO HEIGHTS BLOCK / SECTION LOT 17-20' LOT AREA 100' x 200' SITE CLASS. PS DESIGN FLOW 240 L.T.A.R. EXISTING 0.30 GPD/FT2

Septic Tank: EXISTING Gallons; STB Date

Pump Tank: Gallons; PT Date

Pump Make: Model Serial No.

Nitrification Field: No Fields 1 Square Feet Linear Feet 88

No Lines TWO Trench Width 36" Max Trench Bottom Depth 36" Gravel Depth N/A

☐ New System ☑ Repair System Type: I, II, III, IV, V, VI

System Description:

Repair System Description: 25% REDUCTION, GRAVITY

Maintenance Agreement Required: ☐ Yes ☑ No

☑ House/Mod. Home No. Bedrooms 2

☐ Mobile Home No. Bathrooms 2

☐ Business No. Employees

☐ Other


☐ Slab ☑ Crawl Space ☐ Basement w/plumbing ☐ Basement wo/plumbing

Water Supply: ☐ Individual ☑ Public ☐ Community


Comments:/Conditions: ① RELOCATE WATER LINE AS SHOWN ② INSTALL NEW 3" x 80' SUPPLY LINE AS SHOWN INTO ONE NEW DROP BOX FEEDING TWO NEW 3' x 44' LINES USING 25% REDUCTION SYSTEM

Comments:/Conditions:

INITIAL SITE SKETCH

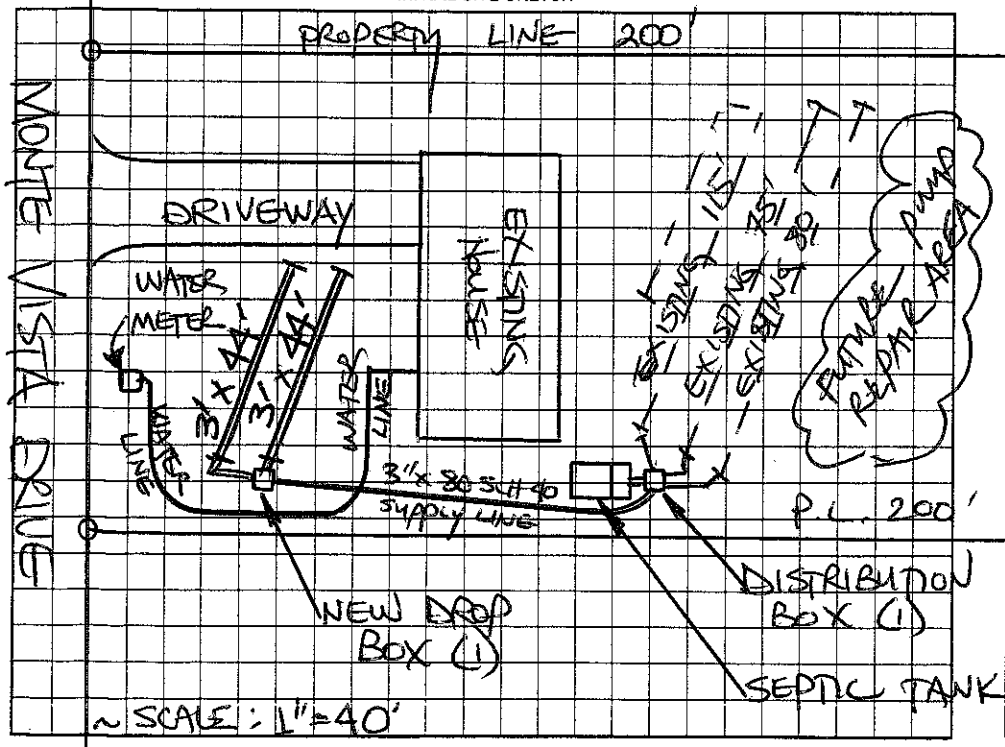

AS BUILT SKETCH

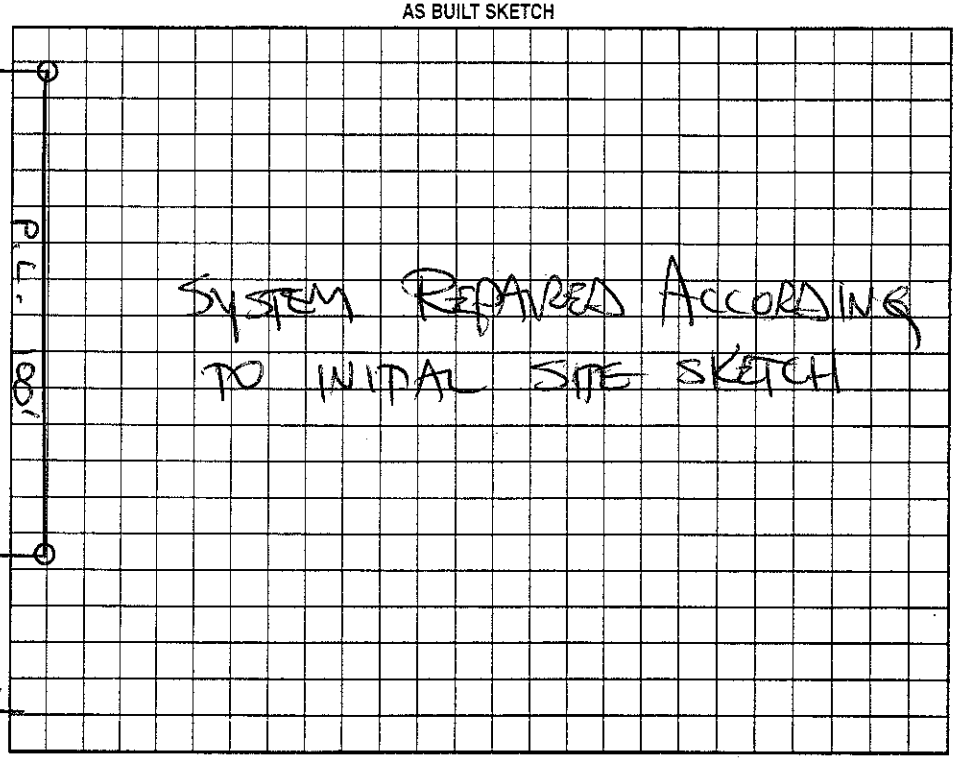

Permit can be suspended or revoked if any false information is supplied toward securing the permit/any unauthorized changes are made to the site/any unauthorized changes are made in the installation of the system. Improvement Permit with plat valid without expiration. Improvement Permit with site plan valid for sixty months. Authorization to Construct is valid for a period equal to that of Improvement Permit – not to exceed sixty months.

Signed: Rhonda Burrell date 8-17-05 Installed by: TIM ABEE

Improvement Permit by: STEVE HEDRICK date 8-17-05 Operation Permit by: STEVE HEDRICK date 2-21-06

Authorization to Construct by: STEVE HEDRICK date 8-17-05 Existing System Inspection by: date

HEALTH DEPT. COPY: WHITE OWNER COPY (FINAL): YELLOW OWNER COPY (INITIAL): PINK