IREDELL COUNTY HEALTH DEPARTMENT

STATESVILLE 704-878-5305 MOORESVILLE 704-664-5261

57647

IMPROVEMENT PERMIT / CERTIFICATE OF COMPLETION / OPERATION PERMIT / EXISTING SYSTEM INSPECTION

PROPERTY DESCRIPTION NO. CITY DATE 5/22/95 TAX MAP NO. 6K-21A-17 Watershed: ☐ Yes ☑ No

OWNER OR CONTRACTOR RHONDA JOANN BURRELL PHONE: Business Home 872-9967

ADDRESS 118 SIGNAL HILL DR APT #104 STATESVILLE, NC 28677

LOCATION NC 90 W TR MONTICELLO DR, TR MONTE VISTA, 4TH LOT ON RIGHT

SUBDIVISION MONTICELLO HEIGHTS BLOCK / SECTION LOT 17-20 LOT AREA 100' X 200' SITE CLASS. PS DESIGN FLOW 240 L.T.A.R. 0.30 GPD/FT

Septic Tank: 1000 Gallons; STB 1012 Date 4-10-96
Pump Tank: Gallons; PT Date
Pump Make: Model Serial No.
Nitrification Field: No Fields Square Feet 310 Linear Feet 270
No Lines 3 Trench Width 36" Max Trench Bottom Depth 18 - 36" Gravel Depth 12"

☑ New System ☐ Repair System Type: I, II, III, IV, V, VI
System Description: CONVENTIONAL GRAVITY
Repair System Description: CONV. GRAVITY
Maintenance Agreement Required: ☐ Yes ☑ No


☑ House/Mod. Home No. Bedrooms 2
☐ Mobile Home No. Bathrooms 2
☐ Business No. Employees
☐ Other
☐ Slab ☑ Crawl Space ☐ Basement w/plumbing ☐ Basement wo/plumbing

Water Supply: ☐ Individual ☐ Community ☑ Public


Comments: ① KEEP SYSTEM MINIMUM 5' FROM HOUSE, 10' FROM PROPERTY LINE ② INSTALL LINES ON CONTOUR NO DEEPER THAN 36", 9' MINIMUM APART ON CENTER.

Comments:

INITIAL SITE SKETCH

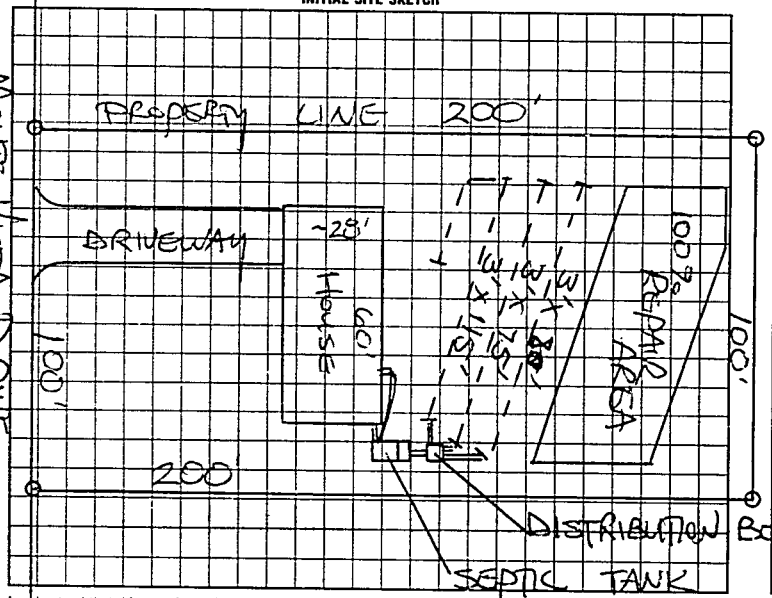

AS BUILT SKETCH

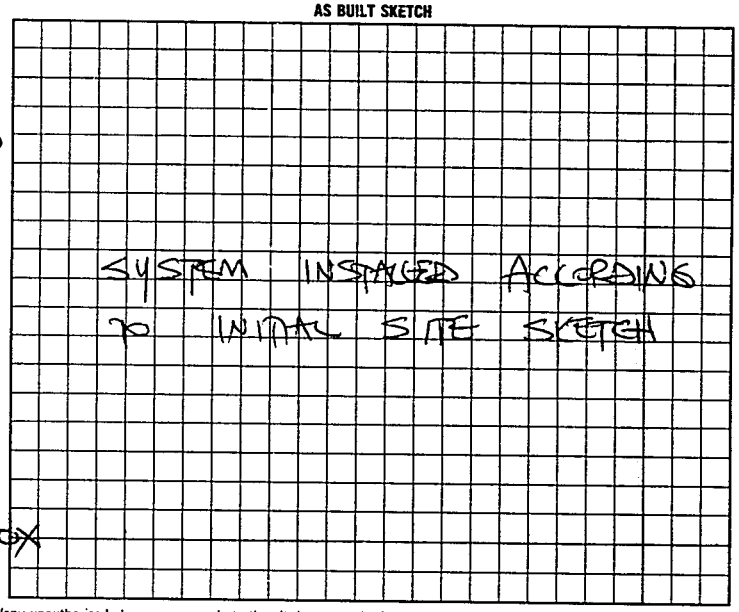

I understand that this permit can be suspended or revoked if any false information is supplied toward securing the permit/any unauthorized changes are made to the site/any unauthorized changes are made in the installation of the system. Improvement Permit is valid for 60 months from date of issuance.

Signed:

Improvement Permit by: STEVE HEDRICK date 5/22/95

Existing System Inspection by: date

Installed by: KENNY MADISON

Certificate of Completion by: date

Operation Permit by: STEVE HEDRICK date 6-20-96

HEALTH DEPT. COPY: WHITE INSPECTION COPY (FINAL): GREEN OWNER COPY (FINAL): YELLOW INSPECTION COPY (INITIAL): PINK OWNER COPY (INITIAL): GOLD

0027 3 5