IREDELL COUNTY HEALTH DEPARTMENT

STATESVILLE 704-878-5305 (1) MOORESVILLE 704-664-5281

IMPROVEMENT PERMIT / AUTHORIZATION TO CONSTRUCT / OPERATION PERMIT / EXISTING SYSTEM INSPECTION

PERMIT# 113060 PIN# 4725-74-6903 DATE 6/20/03

OWNER OR CONTRACTOR Derek Osborne Builders PHONE: Business (704) 902-3084 Home

ADDRESS P.O. Box 1783 Statesville N.C. 28687

LOCATION Hwy 115 N (2) Old Wilkesboro Hwy (3) Monticello (4) Audubon Acres

SUBDIVISION Audubon Acres BLOCK / SECTION - LOT 41 LOT AREA .5797 Acres SITE CLASS. PS DESIGN FLOW 360 L.T.A.R. .25 apd/ftr2

Septic Tank: 1,000 Gallons; STB 1017 Date 6-15-03
Pump Tank: Gallons; PT Date
Pump Make: Model Serial No.
Nitrification Field: No Fields 1 Square Feet Equiv to 1440 Linear Feet 240
No Lines 8@30' Trench Width 2FT Max Trench Bottom Depth 36" Gravel Depth 6" Stone

☒ New System ☐ Repair System Type: I, II, (III), IV, V, VI
System Description: Gravity, 50% Reduction
Repair System Description: Pump, LPP
Maintenance Agreement Required: ☐ Yes ☒ No

☒ House/Mod. Home No. Bedrooms 3
☐ Mobile Home No. Bathrooms 2
☐ Business No. Employees
☐ Other
☐ Slab ☒ Crawl Space ☐ Basement w/plumbing ☐ Basement wo/plumbing


Water Supply: ☐ Individual ☒ Public ☐ Community

Comments:/Conditions: (1) No cutting between House + Monticello Rd in Repair Area (2) Install 3 (three) Flow dividers tees and 4 four Jet boxes with 50% Reduction System - 56 Panels with 40 tons of Sand (3) maintain proper Setbacks


Comments:/Conditions: (1) SEPTIC TANK WITH MARKER INSTALLED USING "TUFTITE" FILTER (2) DRAWLINES INSPECTED 12-3-03, INSTALLED DEEP (3) HEADER DITCH REMAINS TO BE INSPECTED

INITIAL SITE SKETCH

Scale 1"=50'

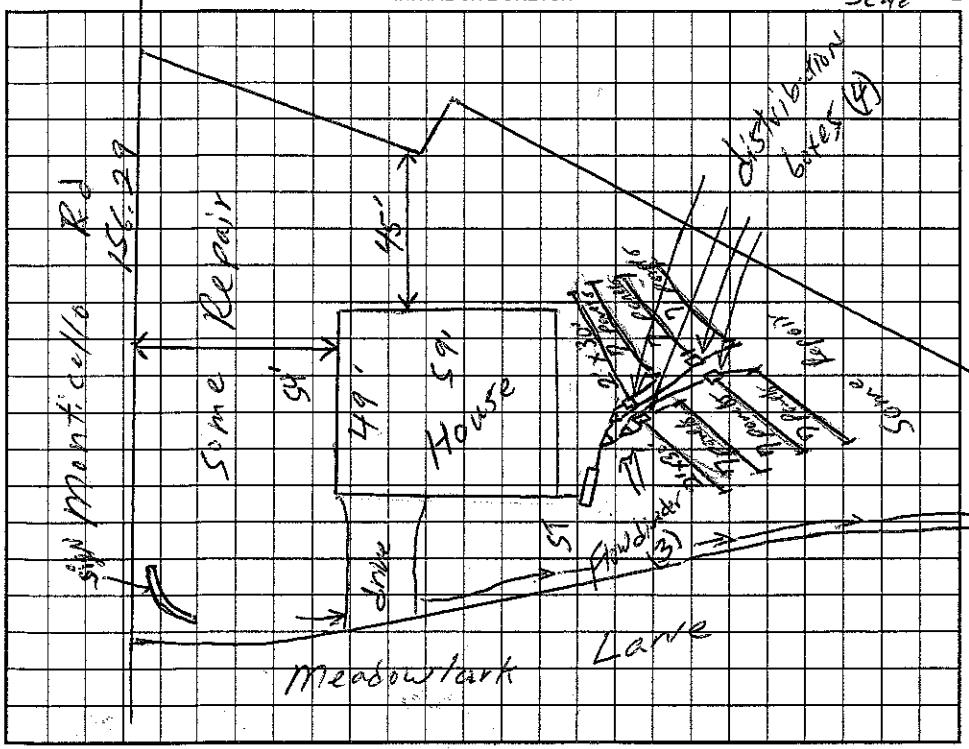

AS BUILT SKETCH

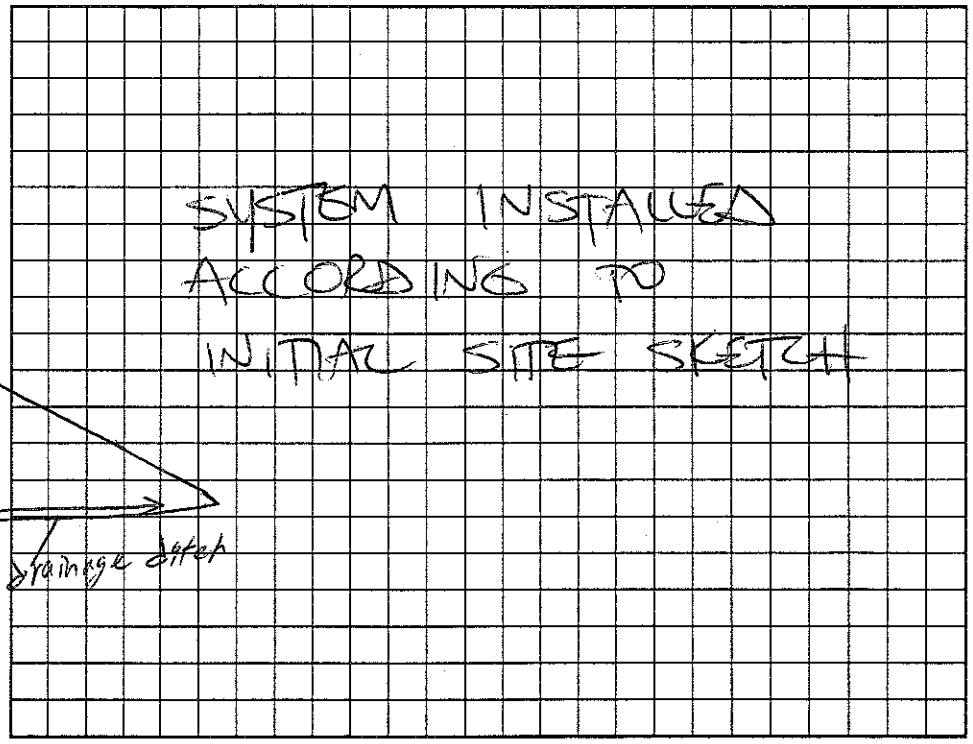

Permit can be suspended or revoked if any false information is supplied toward securing the permit/any unauthorized changes are made to the site/any unauthorized changes are made in the installation of the system. Improvement Permit with plat valid without expiration. Improvement Permit with site plan valid for sixty months. Authorization to Construct is valid for a period equal to that of Improvement Permit – not to exceed sixty months.

Signed: D Osborne date

Improvement Permit by: date 6/20/03

Authorization to Construct by: date 6/20/03

Installed by: [redacted] TOMMY FRYE

Operation Permit by: STEVE HEDRICK date 12-8-03

Existing System Inspection by: date

HEALTH DEPT. COPY: WHITE OWNER COPY (FINAL): YELLOW OWNER COPY (INITIAL): PINK