IREDELL COUNTY HEALTH DEPARTMENT

STATESVILLE 704-878-5305 MOORESVILLE 704-664-5281

#64016

IMPROVEMENT PERMIT / CERTIFICATE OF COMPLETION / OPERATION PERMIT / EXISTING SYSTEM INSPECTION

PROPERTY DESCRIPTION NO. City of Statesville DATE 10-3-96 TAX MAP NO. 6K-1-B-7 Watershed: ☐ Yes ☒ No

OWNER OR CONTRACTOR Claudette Ballard PHONE: Business 878-6323 Home

ADDRESS 2032 Hazelwood Drive Statesville NC

LOCATION 115 N to Old Wilkesboro Rd TL Montecello Dr left on Monte Vista Dr 2nd lot on left

SUBDIVISION Montecello Heights BLOCK / SECTION LOT 7 LOT AREA 125 x 200 SITE CLASS. PIS DESIGN FLOW 360 L.T.A.R. 0.35

Septic Tank: 1000 Gallons; STB 1012 Date 11-6-96

Pump Tank: Gallons; PT Date

Pump Make: Model Serial No.

Nitrification Field: No Fields 1 Square Feet 1029 Linear Feet 343

No Lines 4 Trench Width 36in Max Trench Bottom Depth 36in Gravel Depth 12in

☒ New System ☐ Repair System Type: I, II, III, IV, V, VI

System Description: gravity Conventional

Repair System Description: gravity conven / Pump conv

Maintenance Agreement Required: ☐ Yes ☒ No

☒ House/Mod. Home ☐ Mobile Home ☐ Business ☐ Other

No. Bedrooms 3 No. Bathrooms 2 No. Employees


☐ Slab ☒ Crawl Space ☐ Basement w/plumbing ☐ Basement wo/plumbing

Water Supply: ☐ Individual ☐ Community ☒ Public


Comments: Keep lines on contour, 9ft on center
Smooth out terraces, use 4 D Boxes

Comments: Tank Below A/C unit
Deck location moved up

INITIAL SITE SKETCH

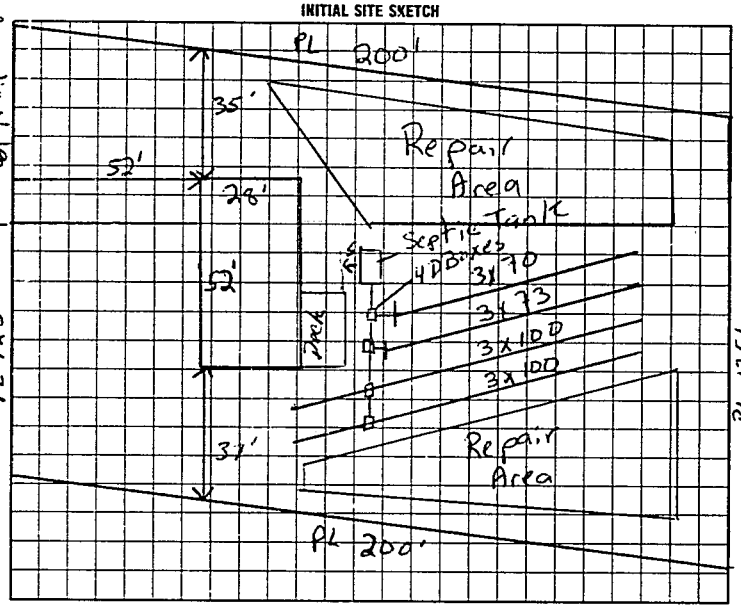

AS BUILT SKETCH

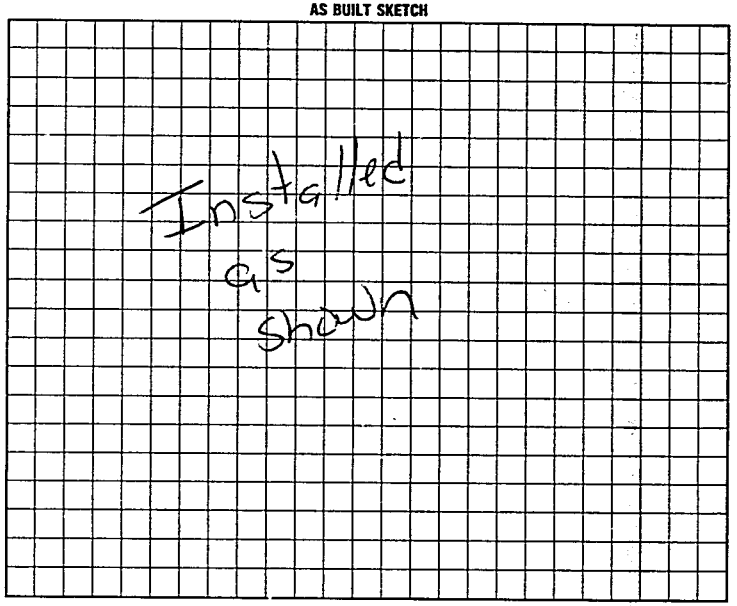

I understand that this permit can be suspended or revoked if any false information is supplied toward securing the permit/any unauthorized changes are made to the site/any unauthorized changes are made in the installation of the system.

Authorization to construct expires 5 yrs after issue

Signed: Claudette Ballard

Authorization to construct Improvement Permit by: Mary C Outz RS date 10-7-96

Existing System Inspection by: Mary C Outz RS date 10-7-96

Installed by: Timmy Frye

Certificate of Completion by: date

Operation Permit by Mary C Outz RS date 2-26-97

HEALTH DEPT. COPY: WHITE INSPECTION COPY (FINAL): GREEN OWNER COPY (FINAL): YELLOW INSPECTION COPY (INITIAL): PINK OWNER COPY (INITIAL): GOLD

1 5 2 2 0 0