IREDELL COUNTY HEALTH DEPARTMENT

STATESVILLE 704-878-5305 MOORESVILLE 704-664-5281

56142

IMPROVEMENT PERMIT / CERTIFICATE OF COMPLETION / OPERATION PERMIT / EXISTING SYSTEM INSPECTION

PROPERTY DESCRIPTION NO. CITY DATE 5/31/95 TAX MAP NO. 6K-1-B-1 Watershed: ☐ Yes ☑ No

OWNER OR CONTRACTOR SHERMAN TAGGETT PHONE: Business Home (203) 589-3525

ADDRESS 47 HIGH ST. TERRYVILLE, CT 06786

LOCATION NC 90W, TR MONTICELLO, TR MONTE VISTA, 1ST LOT ON LEFT

SUBDIVISION MONTE VISTA HEIGHTS SECTION LOT 1 LOT AREA 190x245x150x GRD CLASS. PS DESIGN FLOW 360 L.T.A.R. 0.3 GPD/FT2

Septic Tank: 1000 Gallons; STB 1012 Date 3-4-97

Pump Tank. Gallons; PT Date

Pump Make: Model Serial No.

Nitrification Field: No Fields 1 Square Feet 1200 Linear Feet 400

No Lines 3 Trench Width 36" Max Trench Bottom Depth 18-36" Gravel Depth 12"

☑ New System ☐ Repair System Type: I (II) III, IV, V, VI

System Description: CONVENTIONAL GRAVITY

Repair System Description: CONV. GRAVITY

Maintenance Agreement Required: ☐ Yes ☑ No

☑ House/Mod. Home No. Bedrooms 3

☐ Mobile Home No. Bathrooms 2

☐ Business No. Employees

☐ Other


☐ Slab ☐ Crawl Space ☐ Basement w/plumbing ☑ Basement wo/plumbing

Water Supply: ☐ Individual ☐ Community ☑ Public

Comments: ① KEEP SYSTEM MINIMUM 20' FROM BASEMENT FOUNDATION DRAIN, 50' FROM NEIGHBORING WELL ② INSTALL LINES AS SHOWN, ON CONTOUR, NO DEEPER THAN 36"

Comments:

INITIAL SITE SKETCH

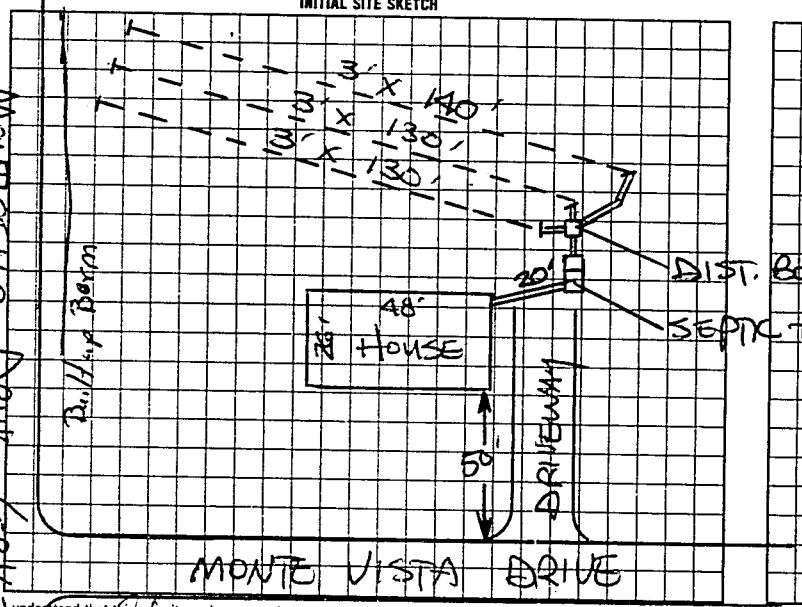

AS BUILT SKETCH

Installed as shown

I understand that this permit can be suspended or revoked if any false information is supplied toward securing the permit/any unauthorized changes are made to the site/any unauthorized changes are made in the installation of the system. Improvement Permit is valid for 60 months from date of issuance.

Signed: S Sherman (Agent)

Improvement Permit by: STEVE FEDRICK date 5/31/95

Existing System Inspection by: date

Installed by: Kenny Madison

Certificate of Completion by: date

Operation Permit by: Mark C Ortes RS date 5-6-97

HEALTH DEPT. COPY: WHITE INSPECTION COPY (FINAL): GREEN OWNER COPY (FINAL): YELLOW INSPECTION COPY (INITIAL): PINK OWNER COPY (INITIAL): GOLD

9562 00