IREDELL COUNTY HEALTH DEPARTMENT

STATESVILLE 704-878-5305 MOORESVILLE 704-664-5281

IMPROVEMENT PERMIT / CERTIFICATE OF COMPLETION / OPERATION PERMIT / EXISTING SYSTEM INSPECTION

PROPERTY DESCRIPTION NO. CITY DATE TAX MAP NO. 6K-A-7 Watershed: ☐ Yes ☐ No

OWNER OR CONTRACTOR JEFFREY THOMAS HENSLEY PHONE: Business Home 872-1021

ADDRESS 113 CECIL DRIVE

LOCATION NC 90 W, TR MONTECELLO DR TL CECIL DRIVE, 4TH MH ON LEFT


SUBDIVISION EDWARDS MHP BLOCK / SECTION LOT 4 LOT AREA LIMITED SITE CLASS PS DESIGN FLOW 240 L.T.A.R. EXISTING

Septic Tank: EXISTING Gallons; STB Date	☐ New System ☐ Repair System Type: I, II, III, IV, V, VI	☐ House/Mod. Home No. Bedrooms 2	Water Supply:
Pump Tank: Gallons; PT Date	System Description: CONV. GRAVITY	☐ Mobile Home No. Bathrooms 2	☐ Individual
Pump Make: Model Serial No.	Repair System Description:	☐ Business No. Employees	☑ Community
Nitrification Field: No Fields Square Feet Linear Feet EXISTING	Maintenance Agreement Required: ☐ Yes ☐ No	☐ Other	☐ Public
No Lines Trench Width Max Trench Bottom Depth	Gravel Depth	☐ Slab ☑ Crawl Space ☐ Basement w/plumbing ☐ Basement wo/plumbing	


Comments:

Comments: CONNECTION TO EXISTING MHP SYSTEM

INITIAL SITE SKETCH

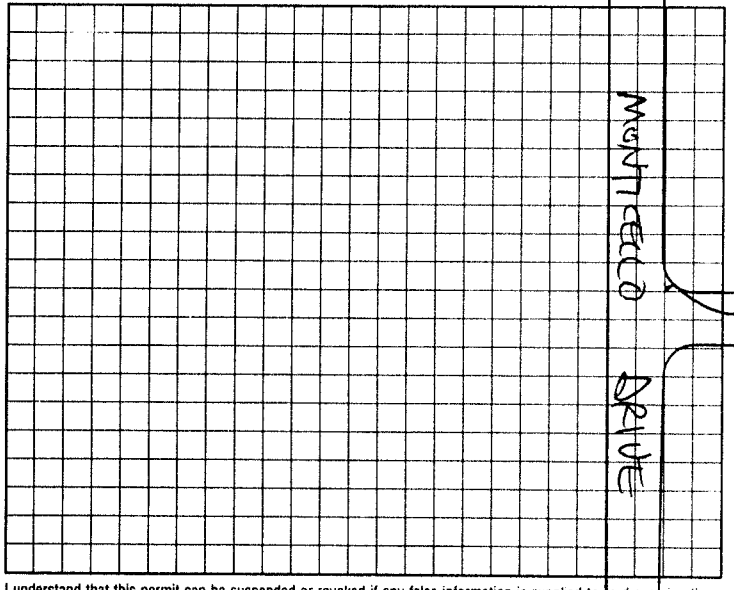

AS BUILT SKETCH

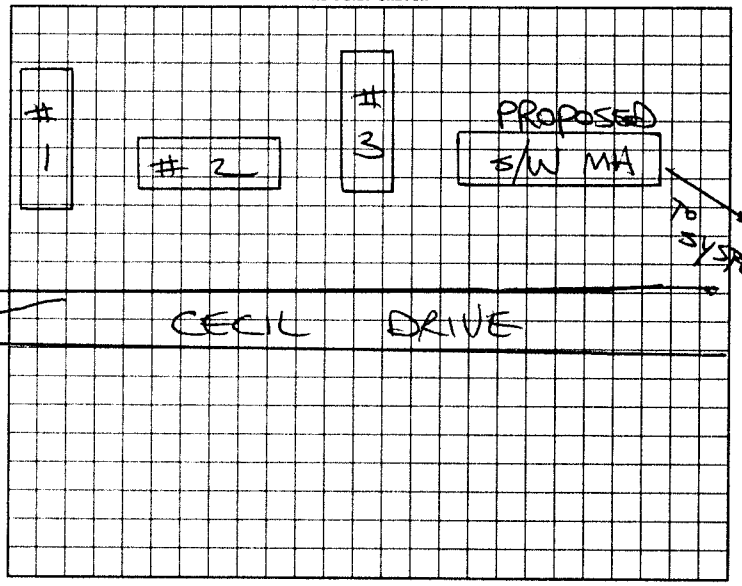

I understand that this permit can be suspended or revoked if any false information is supplied toward securing the permit/any unauthorized changes are made to the site/any unauthorized changes are made in the installation of the system. Improvement Permit is valid for 60 months from date of issuance.

Signed:

Improvement Permit by: date

Existing System Inspection by: STEVE HEDRICK date 1-6-97

Installed by:

Certificate of Completion by: date

Operation Permit by: date

HEALTH DEPT. COPY: WHITE INSPECTION COPY (FINAL) GREEN OWNER COPY (FINAL) YELLOW INSPECTION COPY (INITIAL) PINK OWNER COPY (INITIAL): GOLD