IREDELL COUNTY HEALTH DEPARTMENT

STATESVILLE 704-878-5305 MOORESVILLE 704-664-5281

IMPROVEMENT PERMIT / CERTIFICATE OF COMPLETION / OPERATION PERMIT / EXISTING SYSTEM INSPECTION

PROPERTY DESCRIPTION NO. CITY DATE 1-13-97 TAX MAP NO. 6K-19-A-43 Watershed: ☐ Yes ☑ No

OWNER OR CONTRACTOR DAVID S. HARRINGTON PHONE: Business Home 871-

ADDRESS 1012 4TH CREEK LANDING DR, STATESVILLE NC 28677

LOCATION NC 90 W, TR MONTICELLO DRIVE, TL MEADOWLARK LANE, 2ND LOT ON RIGHT

SUBDIVISION AUDUBON ACRES BLOCK / SECTION LOT 43 LOT AREA 0.6483 ACRE SITE CLASS. PS DESIGN FLOW 360 L.T.A.R. 0.30 GPD/FT²

Septic Tank: 1000 Gallons; STB 101.7 Date 9-8-97

Pump Tank: 1000 Gallons; PT 17 Date 10-12-97

Pump Make: Hydromatic Model SHEF50M1 Serial No. 51867-005

Nitrification Field: No Fields 1 Square Feet 1200 Linear Feet 300+

No Lines FIVE Trench Width 36" Max Trench Bottom Depth 36"

☑ New System ☐ Repair System Type: I, II, III, IV, V, VI

System Description: CHAMBERED PUMP

Repair System Description: PRBPS, PUMP

Maintenance Agreement Required: ☐ Yes ☑ No

Gravel Depth N/A

☑ House/Mod. Home No. Bedrooms 3

☐ Mobile Home No. Bathrooms 3½

☐ Business No. Employees

☐ Other ½ BATH IN SHED


☐ Slab ☐ Crawl Space ☑ Basement w/plumbing ☐ Basement wo/plumbing

Water Supply: ☐ Individual ☐ Community ☑ Public


Comments: ① INSTALL 50 CHAMBERS IN FIVE EQUAL LENGTH LINES AS FLAGGED & SHOWN BELOW ON CONTOUR ② SEE ATTACHED SHEETS FOR PUMP AND PRESSURE MANIFOLD REQUIREMENTS.

Comments: * Homeowner has Jacuzzi

INITIAL SITE SKETCH SCALE: 1" = 40'

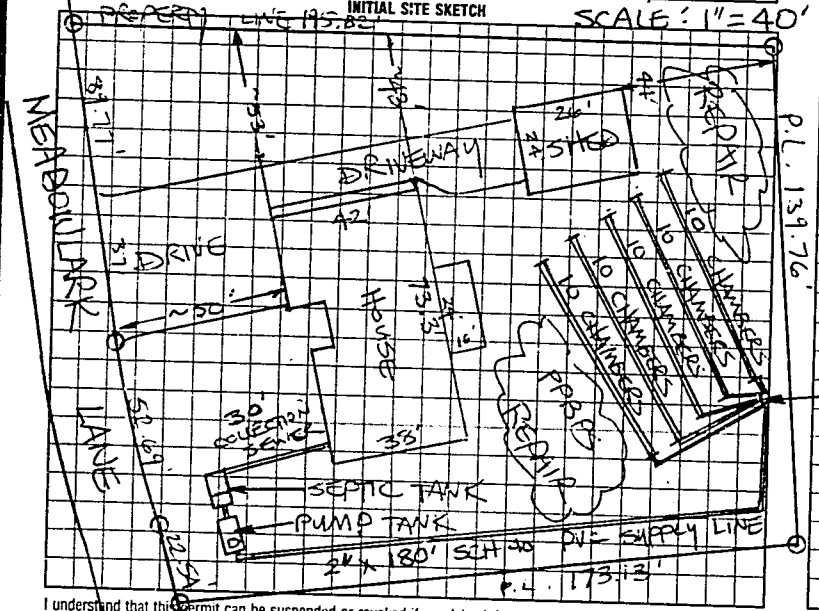

AS BUILT SKETCH

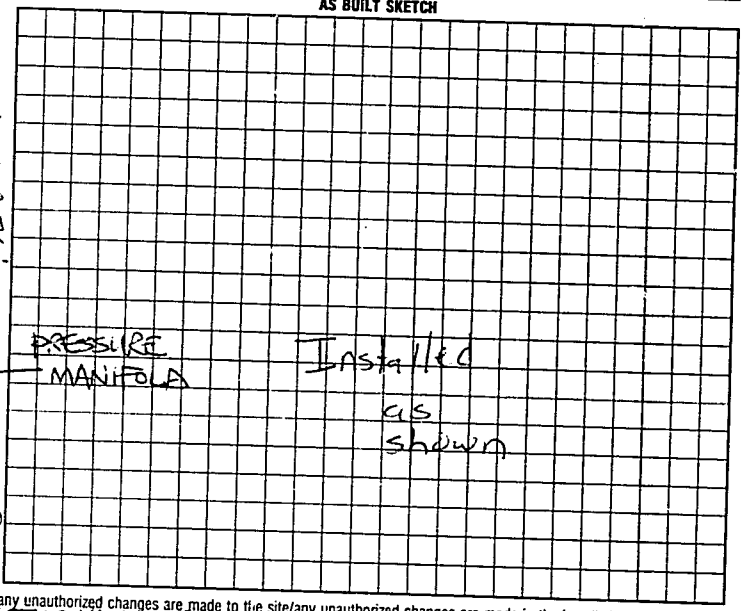

I understand that this permit can be suspended or revoked if any false information is supplied toward securing the permit/any unauthorized changes are made to the site/any unauthorized changes are made in the installation of the system. Improvement Permit is valid for 60 months from date of issuance. AUTHORIZATION TO CONSTRUCT IS VALID FOR 60 MONTHS FROM DATE OF ISSUANCE.

Signed: [signature]

Improvement Permit by: STEVE HENDRICK date 1-13-97

AUTHORIZATION TO CONSTRUCT

Existing System Inspection by: STEVE HENDRICK date 1-13-97

Installed by: TOMMY ALLEN

Certificate of Completion by: date

Operation Permit by: [signature] date 12-31-97

HEALTH DEPT. COPY WHITE | INSPECTION COPY (FINAL): GREEN | OWNER COPY (FINAL): YELLOW | INSPECTION COPY (INITIAL): PINK | OWNER COPY (INITIAL): GOLD