IREDELL COUNTY HEALTH DEPARTMENT

STATESVILLE 704-878-5305 MOORESVILLE 704-664-5281

IMPROVEMENT PERMIT / AUTHORIZATION TO CONSTRUCT / OPERATION PERMIT / EXISTING SYSTEM INSPECTION

PERMIT# 125559 PIN# 4725750467.053 4725782314 DATE 4/28/05

OWNER OR CONTRACTOR D & S PROPERTY MANAGEMENT PHONE: Business 872-5600 Home

ADDRESS 1805 SAFRIET RD - STATESVILLE NC 28625

LOCATION 115 (N) - TL SCOTTS CREEK - TL MILLER FARM - TL DOVE MEADOW LN - ON LT - CORNER OF FAIRPOINT

SUBDIVISION DOVE MEADOWS BLOCK / SECTION II LOT 23 LOT AREA .685AC SITE CLASS. PS DESIGN FLOW 360GPD L.T.A.R. 1360 SQ FT

Septic Tank: 1000 Gallons; STB 835 Date 12-19-07

Pump Tank: 1000 Gallons; PT 302 Date 1-17-08

Pump Make: Model Serial No.

Nitrification Field: No Fields 1 Square Feet 900 Linear Feet 300

No Lines 6@50' Trench Width 36" Max Trench Bottom Depth (18") Gravel Depth

☑ New System ☐ Repair System Type: I, II, (III) IV, V, VI

System Description: PUMP 25% REDUCTION

Repair System Description: LP PANEL/SAME

Maintenance Agreement Required: ☐ Yes ☑ No

☑ House/Mod. Home No. Bedrooms 3

☐ Mobile Home No. Bathrooms 3

☐ Business No. Employees

☐ Other


☐ Slab ☑ Crawl Space ☐ Basement w/plumbing ☐ Basement wo/plumbing

Water Supply: ☐ Individual ☑ Public ☐ Community


Comments:/Conditions: Blue Lafitte

Comments:/Conditions:

1" = 50' INITIAL SITE SKETCH

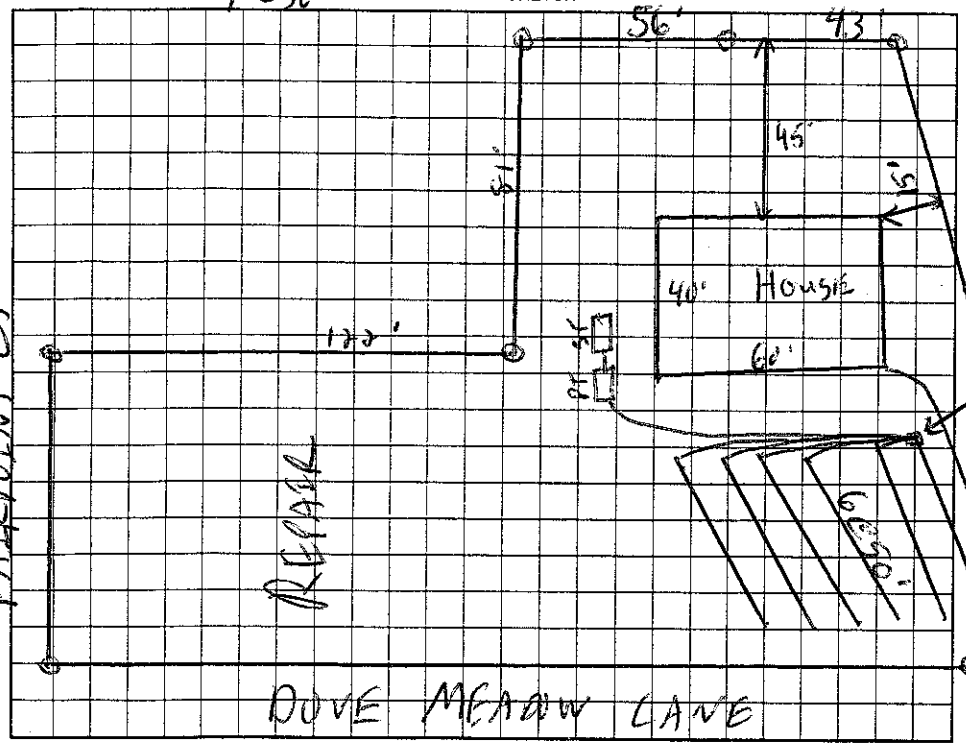

AS BUILT SKETCH

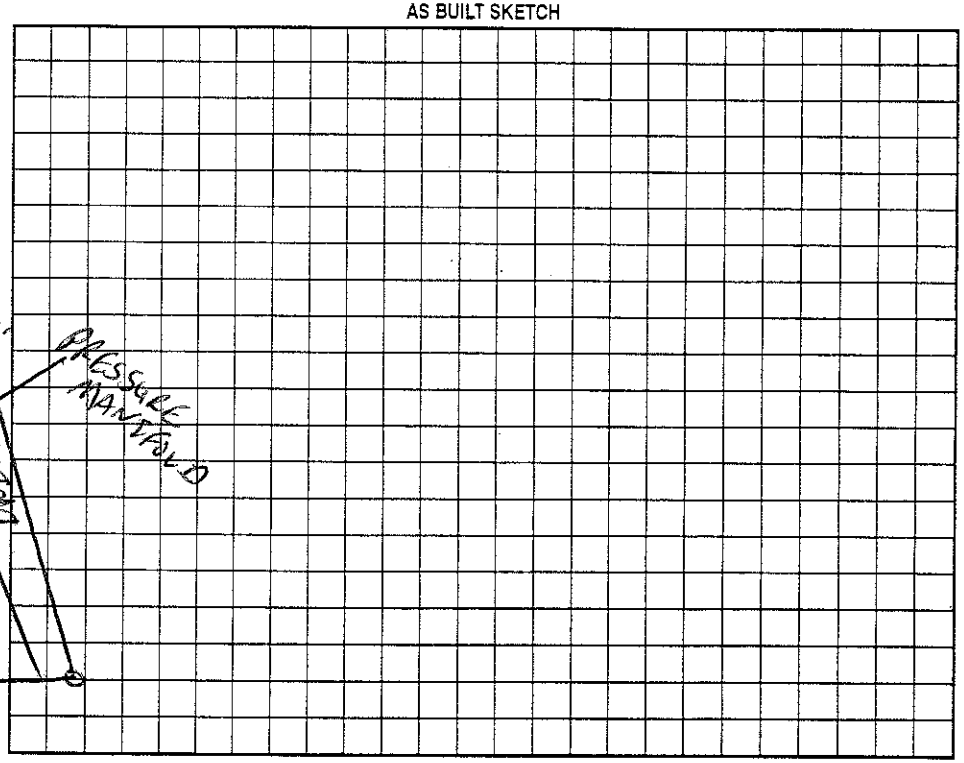

Permit can be suspended or revoked if any false information is supplied toward securing the permit/any unauthorized changes are made to the site/any unauthorized changes are made in the installation of the system. Improvement Permit with plat valid without expiration. Improvement Permit with site plan valid for sixty months. Authorization to Construct is valid for a period equal to that of Improvement Permit – not to exceed sixty months.

Signed: date 5-6-05 Installed by: Jeremy Madison

Improvement Permit by: RS date 4/28/05 Operation Permit by: R.S. date 2 Jul 07

Authorization to Construct by: James Allen date 5-10-06 Existing System Inspection by: date

HEALTH DEPT. COPY: WHITE OWNER COPY (FINAL): YELLOW OWNER COPY (INITIAL): PINK