Replaces Permit #1 issued 4-25-05

IREDELL COUNTY HEALTH DEPARTMENT

STATESVILLE 704-878-5305 CI MOORESVILLE 704-664-5281

IMPROVEMENT PERMIT / AUTHORIZATION TO CONSTRUCT / OPERATION PERMIT / EXISTING SYSTEM INSPECTION

PERMIT# 12556 PIN# 4725 78 2533 DATE 18 December 06

OWNER OR APPLICANT Built-rite Construction / Joe Hyde PHONE: Business 704-201-9935 Home

ADDRESS 295 Treehawk Rd. Statesville, N.C. 28625

LOCATION Scotts Creek Rd. from Hwy 115 TL Miller Farm Rd. TL Dave Meadows TL Fairfax 2nd on Rt.

SUBDIVISION Dave Meadows BLOCK / SECTION 2 LOT 25 LOT AREA 0.487 Ac. SITE CLASS. PS DESIGN FLOW 360 gpd L.T.A.R. 0.5 gpd/ft²/day

Septic Tank: 1000 Gallons; STB 760 Date 10-30-07
Pump Tank: 1000 Gallons; PT / Date /
Pump Make: / Model / Serial No. /
Nitrification Field: No Fields 1 Square Feet = 1200 Linear Feet 300
No Lines 4 Trench Width 36" Max Trench Bottom Depth 18" Gravel Depth DR ☐ Gravity ☑ Pressure

☑ New System ☐ Repair ☐ Expansion System Type: I II III IV V VI
System Description: Pressure - 25% Reduction
Repair System Description: LPP and CAPS
Maintenance Agreement Required: ☐ Yes ☑ No

☑ House/Mod. Home No. Bedrooms 3
☐ Mobile Home No. Persons
☐ Business No. Employees
☐ Other


Water Supply: ☐ Individual ☑ Public ☐ Community

☐ Slab ☑ Crawl Space ☐ Basement w/plumbing ☐ Basement wo/plumbing


Comments/Conditions: Do not cut house pad - Build up for positive drainage - No Foundation Drains / SCH 40 1½" taps 185 gallon dose

Comments/Conditions: Red filter

INITIAL SITE SKETCH

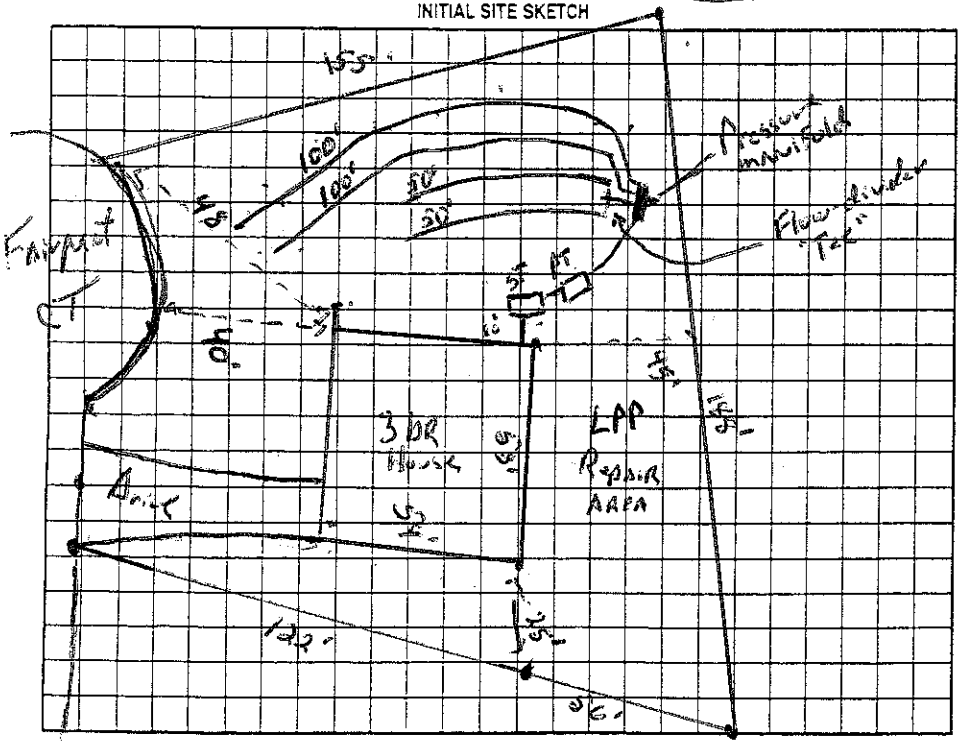

AS BUILT SKETCH

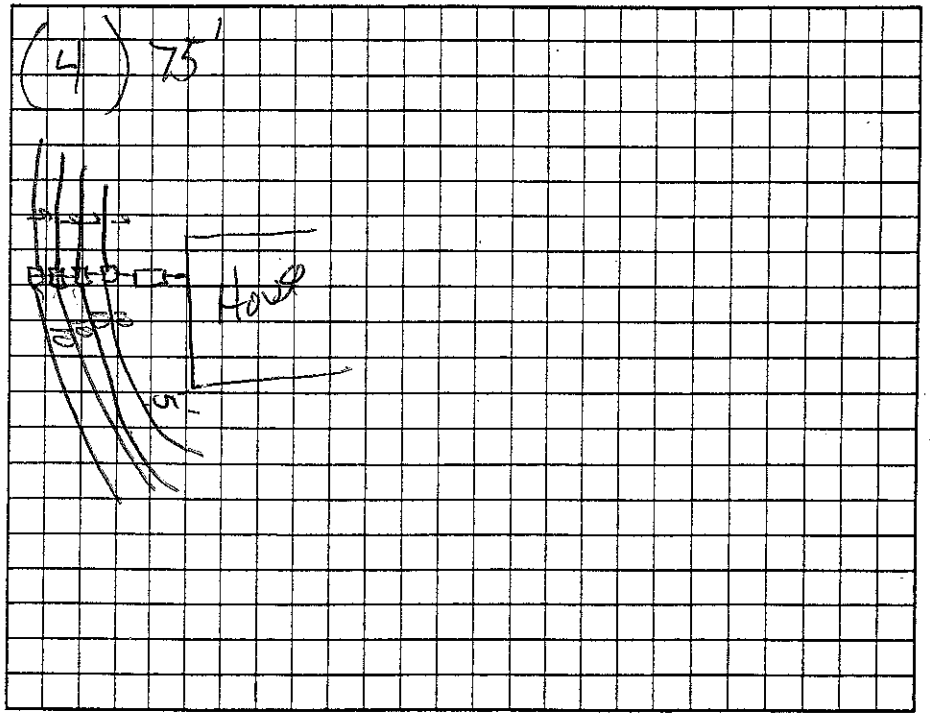

Permit can be suspended or revoked if any false information is supplied toward securing the permit/any unauthorized changes are made to the site/any unauthorized changes are made in the installation of the system. Improvement Permit with plat valid without expiration ☐ Improvement Permit with site plan valid for sixty months ☐ Authorization to Construct is valid for a period equal to that of Improvement Permit – not to exceed sixty months.

Signed: date 20 Dec. 06 Installed by: Madison Grading

Improvement Permit by: R.S. date 20 Dec. 06 Operation Permit by: date 4-3-07

Authorization to Construct by: R.S. date 20 Dec. 06 Existing System Inspection by: date

HEALTH DEPT. COPY: WHITE OWNER COPY (FINAL): YELLOW OWNER COPY (INITIAL): PINK