IREDELL COUNTY HEALTH DEPARTMENT

Statesville Office (704) 878-5305 Mooresville Office (704) 660-3625 PERMIT # 218349

IMPROVEMENT PERMIT / AUTHORIZATION TO CONSTRUCT / OPERATION PERMIT / EXISTING SYSTEM

PIN # 4725-78-3560

APPLICANT: Alan Lewis APPLICANT ADDRESS: 118 New Hope Rd.

SITE ADDRESS: 104 Bird Haven Dr. Statesville, NC PHONE: 704-878-2305 ALT. PHONE:

SITE DIRECTIONS: Rt 115 N from Statesville → L on Scotts Creek Rd → L on Miller Farm Rd → L on Bird Haven Dr → @ end on left of cul-de-sac


SUBDIVISION: Dove Meadows SECTION: Ph-2 LOT # 21 LOT AREA: 0.487 acres DESIGN FLOW: 360 gpd L.T.A.R.: 0.3

Septic Tank	1000 (gal)	STB		Date		☒ New System	☐ Repair	☐ Expansion	System Type: I (II) III IV V VI	☒ Residence	No. Bedrooms 3	Water Supply
Pump Tank	— (gal)	PT	—	Date	—	System Description: 25% Reduction w/serial distribution				☐ Business	No. Persons 6	☐ Private
Pump Make	—	Model	—	Serial #	—	Repair System Description: 50% Reduction - LP. PPBPS				☐ Other	No. Employees	☐ Public
# Nitrification Fields	1	# Lines	4	Linear Ft	300	Maintenance Agreement Required:	☐ YES	☒ NO		☐ Slab	☒ Crawl Space	☒ Community
Trench Width	36"	Max. Trench Bottom Depth	30"	Gravel Depth	—		☒ GRAVITY	☐ PRESSURE		☐ Basement w/plumbing		☐ Basement w/o plumbing


Comments / Conditions: Follow all N.C. septic rules. Recommend pumping septic tank every 3-5 years.

Tanks TPS 1000 gal 9-4-2016.

INITIAL SITE SKETCH

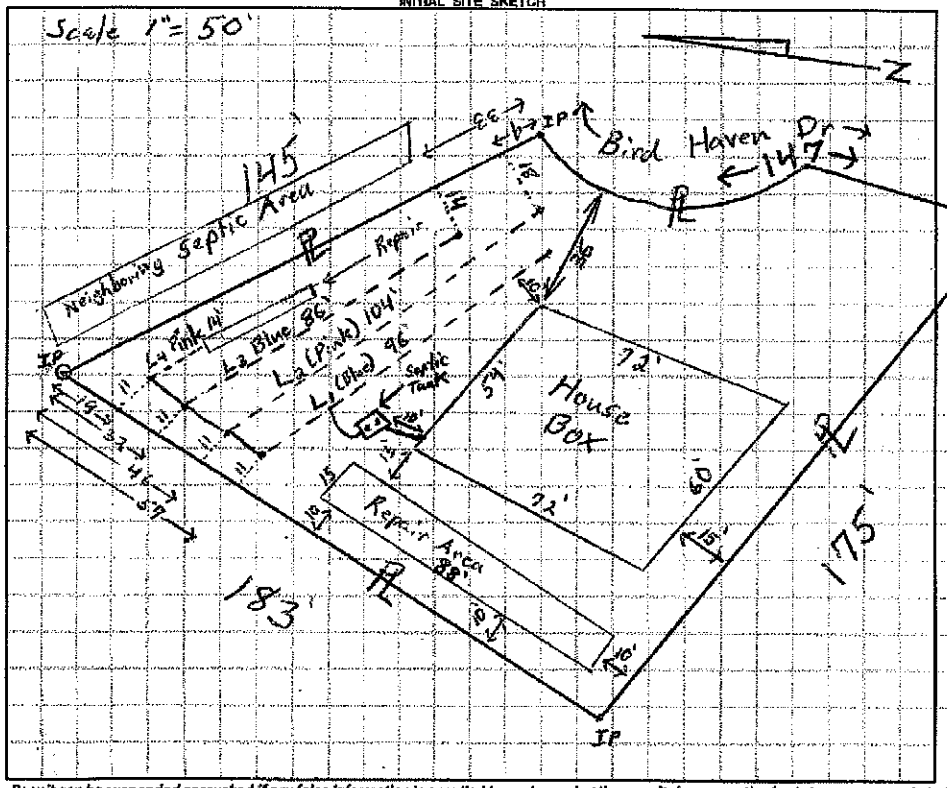

AS BUILT SKETCH

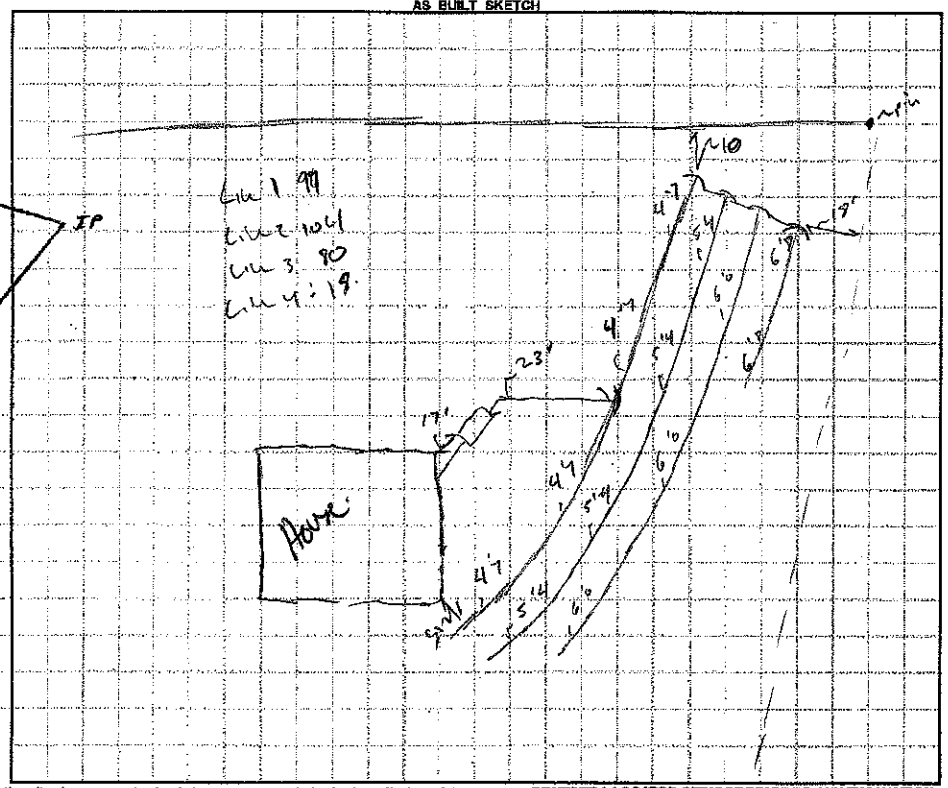

Permit can be suspended or revoked if any false information is supplied toward securing the permit / any unauthorized changes are made to the site / any unauthorized changes are made in the installation of the system. CONTACT A LOCATOR SERVICE PRIOR TO ANY EXCAVATION

☐ IMPROVEMENT PERMIT with plat valid without expiration. ☒ IMPROVEMENT PERMIT with site plan valid for 60 mos. ☒ AUTHORIZATION TO CONSTRUCT valid for period equal to IMPROVEMENT PERMIT--not to exceed 60 mo.

Owner / Applicant Signature: Alan Lewis Date:

IMPROVEMENT PERMIT by: Tom Shuyler Date: 6-22-16

AUTHORIZATION TO CONSTRUCT by: Date: 6/24/16

Installed by: David Hunter

OPERATION PERMIT by: Date: 2/1/17

Existing System Inspected by: Date:

Health Dept. Copy - WHITE Applicant (Final Approval) - YELLOW Applicant (Conditional Approval) - PINK

Bryant A Barnes 2/1/17.