9:30 *THIS PERMIT REPLACES PREVIOUS PERMIT ISSUED 04/28/05.

IREDELL COUNTY HEALTH DEPARTMENT

STATESVILLE 704-878-5305 MOORESVILLE 704-664-5281

IMPROVEMENT PERMIT / AUTHORIZATION TO CONSTRUCT / OPERATION PERMIT / EXISTING SYSTEM INSPECTION

PERMIT# 125555 PIN# 4725-78-4598 DATE 05/23/06

OWNER OR APPLICANT BUILTRITE CONS. - JOE HYDE PHONE: Business 704-201-9935 Home 704-876-1955

ADDRESS 295 TREEBARK RD, STATESVILLE, NC 28625

LOCATION HWY 115 N, (L) SCOTTS CREEK RD, (L) MILLER FARM RD, (L) DOVEMEADOW LN, (L) BIRD HAVEN, AT END ON CUL-DE-SAC

SUBDIVISION DOVE MEADOW BLOCK / SECTION II LOT 20 LOT AREA 0.767 Ac. SITE CLASS. P DESIGN FLOW 360 GPD L.T.A.R. 0.30 GPD/FT²

Septic Tank: 1,000 Gallons; STB 575 Date 6-14-06
Pump Tank: 1,000 Gallons; PT 362 Date 6-24-06
Pump Make: Zoeller Model N152-A Serial No.
Nitrification Field: No Fields 1 Square Feet EQ to 1,200 Linear Feet 300'
No Lines 3 @ 100' Trench Width 36" Max Trench Bottom Depth 36"

[X] New System [ ] Repair [ ] Expansion System Type: I II (III) IV V VI
System Description: PUMP, 25% REDUCTION
Repair System Description: PUMP, 50% REDUCTION
Maintenance Agreement Required: [ ] Yes [X] No

[X] House/Mod. Home No. Bedrooms 3
[ ] Mobile Home No. Persons 6
[ ] Business No. Employees
[ ] Other


Water Supply: [ ] Individual [X] Public [ ] Community

Gravel Depth N/A [ ] Gravity [X] Pressure [ ] Slab [X] Crawl Space [ ] Basement w/plumbing [ ] Basement wo/plumbing

Comments/Conditions: (1) SMOOTH FIELD TERRACE TO PREVENT WATER PONDING
(2) SEE ATTACH PUMP & MANIFOLD INFO. SHEETS.

Comments/Conditions:
Blue - Tuftite, no ST marker, no risers

INITIAL SITE SKETCH

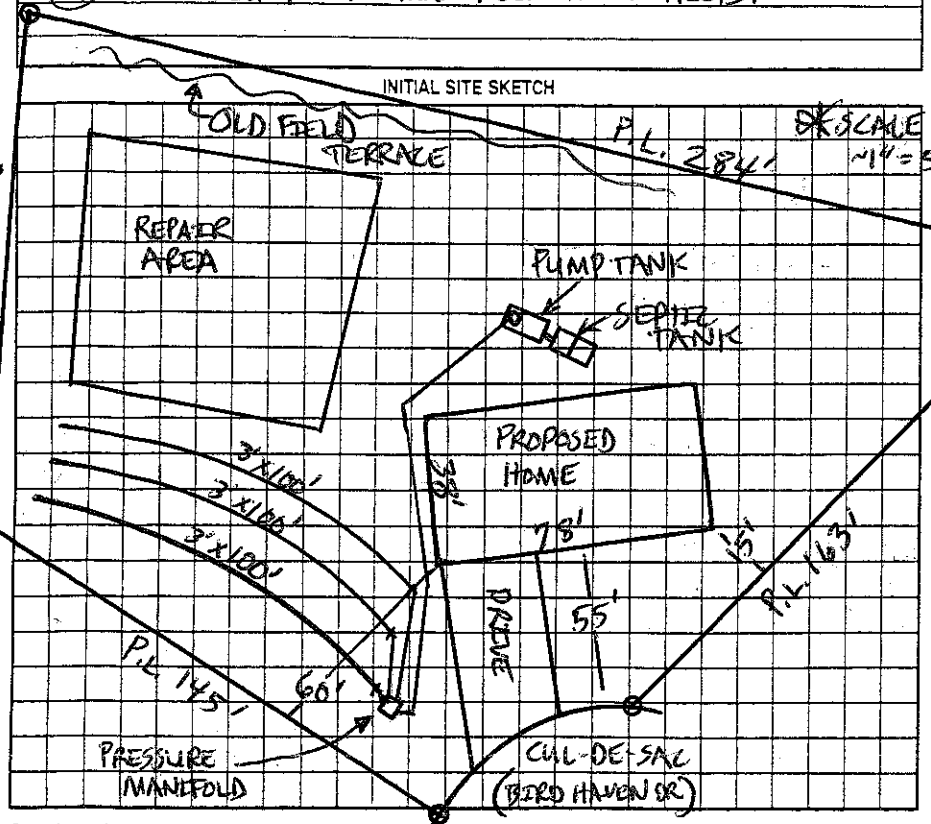

AS BUILT SKETCH

Permit can be suspended or revoked if any false information is supplied toward securing the permit/any unauthorized changes are made to the site/any unauthorized changes are made in the installation of the system. Improvement Permit with plat valid without expiration ☐ Improvement Permit with site plan valid for sixty months ☒ Authorization to Construct is valid for a period equal to that of Improvement Permit – not to exceed sixty months.

Signed: Joe Hyde date 5-23-06 Installed by: Kenny Madison

Improvement Permit by: STEVE HERRICK date 5-23-06 Operation Permit by: Kenny Madison date 9-8-06

Authorization to Construct by: STEVE HERRICK date 5-23-06 Existing System Inspection by: date

HEALTH DEPT. COPY: WHITE OWNER COPY (FINAL): YELLOW OWNER COPY (INITIAL): PINK

Dec Permit #16403 for shed addition on site 11-03-10. 121.7'd