9:30

IREDELL COUNTY HEALTH DEPARTMENT

STATESVILLE 704-878-5305 MOORESVILLE 704-664-5281

IMPROVEMENT PERMIT / AUTHORIZATION TO CONSTRUCT / OPERATION PERMIT / EXISTING SYSTEM INSPECTION

PERMIT# 125555 PIN# 4725-78-4598 DATE 05/23/06

OWNER OR APPLICANT TWILLIGHT CONS. JOE HYDE PHONE: Business 704-201-9935 Home 704-876-1955

ADDRESS 295 TREEBARK RD. STATESVILLE, NC 28625

LOCATION HWY 115 N, (L) SCOTT'S CREEK RD (L) MILLER FARM RD, (L) DOVECREEK LN, (R) BIRD HAVEN, AT END ON CUL-DE-SAC

SUBDIVISION DOVE MEADOW BLOCK / SECTION ____ LOT 20 LOT AREA 0.767 Ac. SITE CLASS. 3 DESIGN FLOW 360 GPD L.T.A.R. 0.30 GPD/FT²

Septic Tank: 1,000 Gallons; STB 4475 Date 6-14-06
Pump Tank: 1,000 Gallons; PT 2447 Date 6-21-06
Pump Make: Zoeller Model A1152-A Serial No. ____
Nitrification Field: No Fields 1 Square Feet EQ to 1200 Linear Feet 300'
No Lines 3 @ 100' Trench Width 36" Max Trench Bottom Depth 36" Gravel Depth N/A ☐ Gravity ☒ Pressure

☒ New System ☐ Repair ☐ Expansion System Type: I II (III) IV V VI
System Description: PUMP, 25% REDUCTION
Repair System Description: PUMP, 50% REDUCTION
Maintenance Agreement Required: ☐ Yes ☒ No

☒ House/Mod. Home ☐ Mobile Home ☐ Business ☐ Other ____
No. Bedrooms 3 No. Persons 6 No. Employees ____


Water Supply: ☐ Individual ☒ Public ☐ Community

☐ Slab ☒ Crawl Space ☐ Basement w/plumbing ☐ Basement wo/plumbing


Comments:/Conditions: (1) SMOOTH FIELD TERRACE TO PREVENT WATER PONDING (2) SEE ASBUILT PUMP & MANIFOLD INFO SHEETS.

Comments:/Conditions: Blue-Turtle, no ST marker, no risers

INITIAL SITE SKETCH

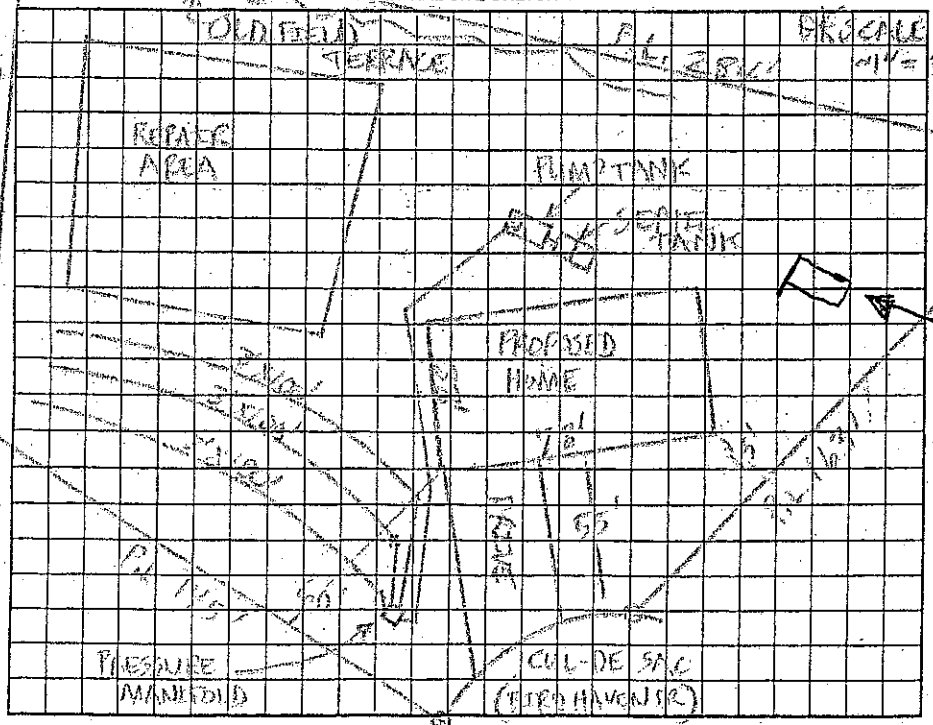

AS BUILT SKETCH

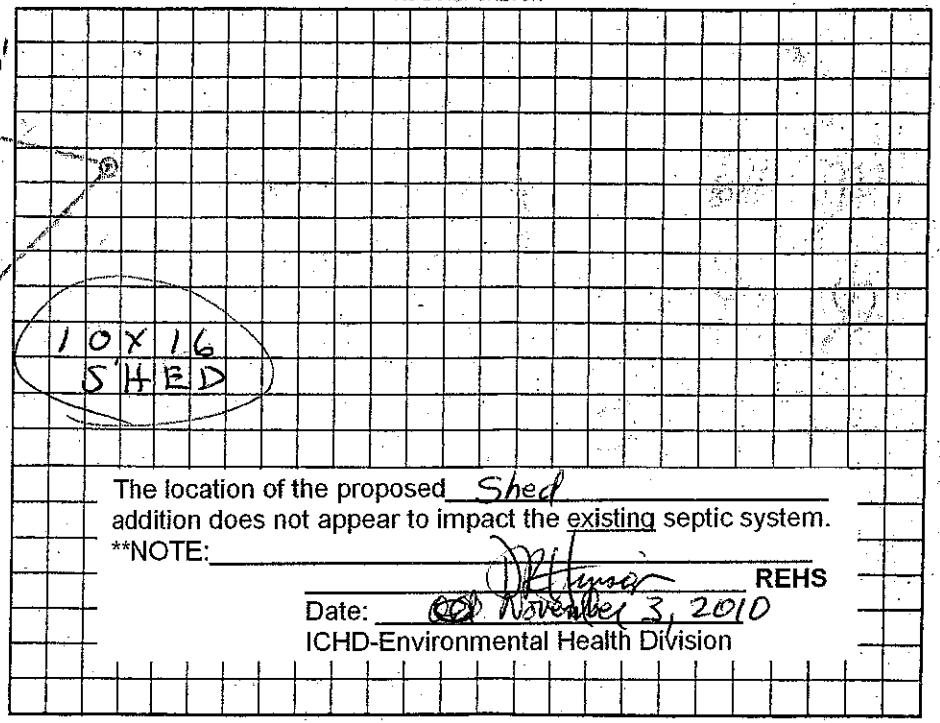

The location of the proposed Shed addition does not appear to impact the existing septic system.
**NOTE: ____

REHS
Date: November 3, 2010
ICHD-Environmental Health Division

Permit can be suspended or revoked if any false information is supplied toward securing the permit/any unauthorized changes are made to the site/any unauthorized changes are made in the installation of the system. Improvement Permit with plat valid without expiration ☐ Improvement Permit with site plan valid for sixty months ☒ Authorization to Construct is valid for a period equal to that of Improvement Permit – not to exceed sixty months.

Signed: ____ date 5-22-06 Installed by: Kenny Madison

Improvement Permit by: STEVE HEDRICK date 5-23-06 Operation Permit by: ____ date ____

Authorization to Construct by: STEVE HEDRICK date 5-23-06 Existing System Inspection by: ____ date ____

HEALTH DEPT. COPY: WHITE OWNER COPY (FINAL): YELLOW OWNER COPY (INITIAL): PINK