*PERMIT REPLACES IP ISSUED ON 4-22-05, NOW VOID

CI

IREDELL COUNTY HEALTH DEPARTMENT

STATESVILLE 704-878-5305 MOORESVILLE 704-664-5281

IMPROVEMENT PERMIT / AUTHORIZATION TO CONSTRUCT / OPERATION PERMIT / EXISTING SYSTEM INSPECTION

PERMIT# 125531 PIN# 4725-78-~~0467~~ 5363 DATE 5-17-05

OWNER OR CONTRACTOR D & S PROPERTY MANAGEMENT PHONE: Business (704) 876-8600 Home

ADDRESS 1805 SAFREIT RD STATESVILLE NC 28625

LOCATION HWY 115 N TL SCOTTS CREEK TL MILLER FARM TL DOVE MEADOW TL BIRD HAVEN ON RT

SUBDIVISION DOVE MEADOWS BLOCK / SECTION I LOT 17 LOT AREA 0.463 SITE CLASS. PS DESIGN FLOW 360 L.T.A.R. 0.30 GPD/FT²

Septic Tank: 1000 Gallons; STB 825 Date 6-28-05

Pump Tank: Gallons; PT Date

Pump Make: Model Serial No.

Nitrification Field: No Fields 1 Square Feet 1200 Linear Feet 300

No Lines 4 Trench Width 36" Max Trench Bottom Depth *18" Gravel Depth N/A

☑ New System ☐ Repair System Type: I, II, (III), IV, V, VI

System Description: GRAVITY 25% REDUCTION

Repair System Description: PUMP 25% REDUCTION

Maintenance Agreement Required: ☐ Yes ☑ No

☑ House/Mod. Home No. Bedrooms 3

☐ Mobile Home No. Bathrooms

☐ Business No. Employees

☐ Other


☐ Slab ☑ Crawl Space ☐ Basement w/plumbing ☐ Basement wo/plumbing

Water Supply: ☐ Individual ☑ Public ☐ Community


Comments:/Conditions: (1) INSTALL SYSTEM LINES NO DEEPER THAN 18" ON CONTOUR (2) MAINTAIN SETBACKS (3) ELEVATION OF PLUMBING CRITICAL OR MAY HAVE TO PUMP

Comments:/Conditions: DOLYLOK FITTING & MARKER INSTALLED AS DRAWN

INITIAL SITE SKETCH

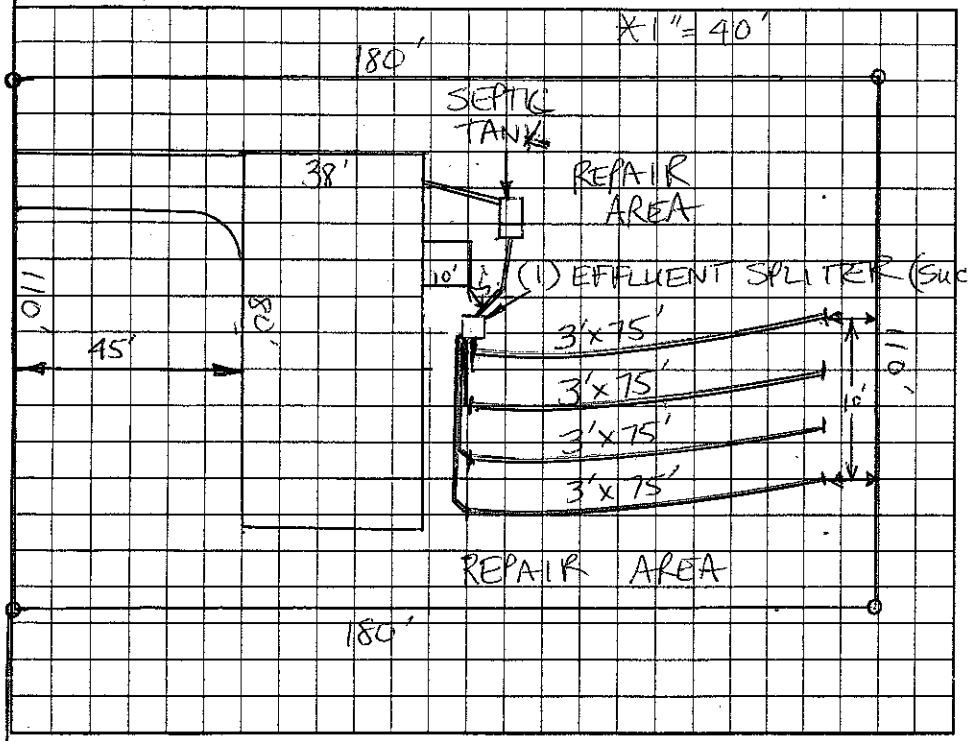

AS BUILT SKETCH

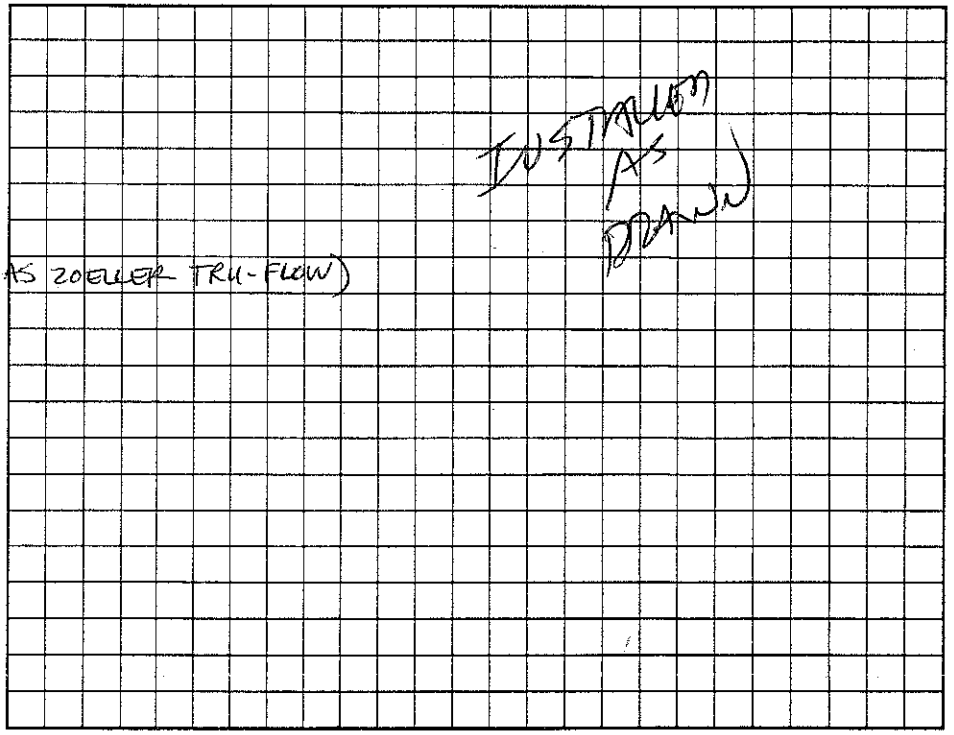

Permit can be suspended or revoked if any false information is supplied toward securing the permit/any unauthorized changes are made to the site/any unauthorized changes are made in the installation of the system. Improvement Permit with plat valid without expiration. Improvement Permit with site plan valid for sixty months. Authorization to Construct is valid for a period equal to that of Improvement Permit – not to exceed sixty months.

Signed: Daniel Lancaster date 5-17-05 Installed by: MR JASON GRADY

Improvement Permit by: Christopher M Sherrill RS, LSS date 5-17-05 Operation Permit by: [illegible] date 9-22-05

Authorization to Construct by: Christopher M Sherrill RS, LSS date 5-17-05 Existing System Inspection by: date

HEALTH DEPT. COPY: WHITE OWNER COPY (FINAL): YELLOW OWNER COPY (INITIAL): PINK