IREDELL COUNTY HEALTH DEPARTMENT

STATESVILLE 704-878-5305 MOORESVILLE 704-664-5281

IMPROVEMENT PERMIT / CERTIFICATE OF COMPLETION / OPERATION PERMIT / EXISTING SYSTEM INSPECTION

PROPERTY DESCRIPTION NO. CITY 00020 DATE 6/16/93

OWNER OR CONTRACTOR C. Douglas Madison, Jr. PHONE: Business 873-0521 Home

TAX MAP NO. PART of 6K-A-85

ADDRESS

LOCATION NC 90 W, TR MONTICELLO DRIVE, TR BRADLEY FARM ROAD, TR CARINGTON LANE, 3RD (LOT ONE)

SUBDIVISION CARINGTON BLOCK / SECTION LOT 20 LOT AREA 95' x 158' SITE CLASS. PS L.T.A.R. 0.40 GAD/FT2

Water Supply: ☐ Individual ☐ Community ☑ Public

Septic Tank: 1000 Gallons; STB 358 Date 4/15/93

Pump Tank: Gallons; PT Date

Nitrification Field: No Fields 1 Square Feet 900 Linear Feet 300

No Lines 2 Trench Width 36" Trench Depth Gravel Depth 12"

☑ New System ☐ Repair System Type: I, II, (III), IV, V, VI

System Description: CONV. GRAVITY

Repair System Description: CONV, PUMP

Maintenance Agreement Required: ☐ Yes ☑ No

☑ House/Mod. Home No. Bedrooms 3

☐ Mobile Home No. Bathrooms 2

☐ Business No. Employees

☐ Other

Garbage Disposal: ☐ Yes ☑ No

Auto. Dishwasher: ☑ Yes ☐ No

Auto. Washing Machine: ☑ Yes ☐ No


Other

☐ Slab ☑ Crawl Space ☐ Basement w/plumbing ☐ Basement wo/plumbing

Comments

INITIAL SITE SKETCH

AS BUILT SKETCH

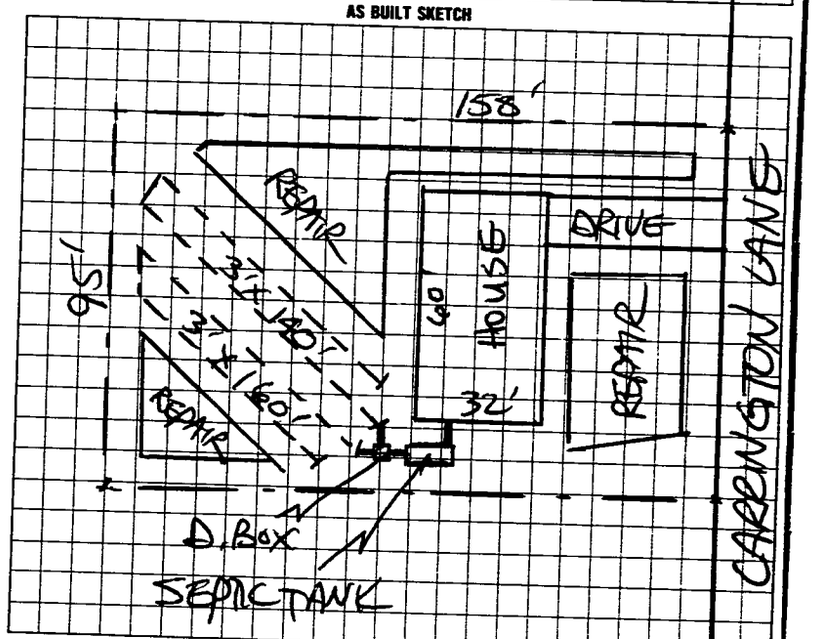

I understand that this permit can be suspended or revoked if any false information is supplied toward securing the permit/any unauthorized changes are made to the site/any unauthorized changes are made in the installation of the system

Improvement Permit is valid for 60 months from date of issuance.

Signed:

Improvement Permit by: STEVE HEDRICK date 6/15/92

Existing System Inspection by: date

Installed by: A-1 BACKHOE

Certificate of Completion by: STEVE HEDRICK date 6/16/93

Operation Permit by: date

HEALTH DEPT. COPY: WHITE INSPECTION COPY (FINAL): GREEN OWNER COPY (FINAL): YELLOW INSPECTION COPY (INITIAL): PINK OWNER COPY (INITIAL): GOLD