IREDELL COUNTY HEALTH DEPARTMENT

STATESVILLE 704-878-5305 MOORESVILLE 704-664-5281

IMPROVEMENT PERMIT / CERTIFICATE OF COMPLETION / OPERATION PERMIT / EXISTING SYSTEM INSPECTION

PROPERTY DESCRIPTION NO. CITY 00021 DATE 6/16/93 TAX MAP NO. PART of 6K-A-85

OWNER OR CONTRACTOR C. DOUGLAS MADISON, JR. PHONE: Business 8730521 Home

ADDRESS

LOCATION NC 90 W, TR MONTICELLO DR, TR BRADLEY FARM RD, TR CARINGTON LN, 2ND LOT ON (R)

SUBDIVISION CARINGTON BLOCK / SECTION LOT 21 LOT AREA 95'x157' SITE CLASS. L.T.A.R.

Water Supply: ☐ Individual ☐ Community ☒ Public

Septic Tank: 1000 Gallons; STB 353 Date 4/15/93

Pump Tank: Gallons; PT Date

Nitrification Field: No Fields 1 Square Feet 900 Linear Feet 300

No Lines 2 Trench Width 36" Trench Depth 36" Gravel Depth 12"

☒ New System ☐ Repair System Type: I. II (III) IV. V. VI

System Description: CONV, GRAVITY

Repair System Description: CONV, PUMP

Maintenance Agreement Required: ☐ Yes ☒ No

☒ House/Mod. Home No. Bedrooms 3

☐ Mobile Home No. Bathrooms 2

☐ Business No. Employees

☐ Other

☐ Slab ☒ Crawl Space ☐ Basement w/plumbing ☐ Basement wo/plumbing

Garbage Disposal: ☐ Yes ☒ No

Auto. Dishwasher: ☒ Yes ☐ No


Auto. Washing Machine: ☒ Yes ☐ No

Other

Comments

INITIAL SITE SKETCH

AS BUILT SKETCH

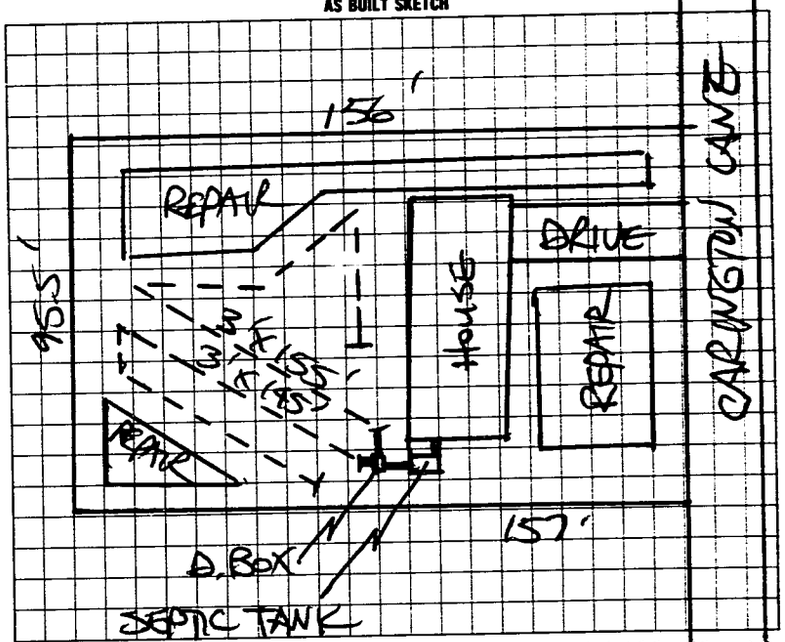

I understand that this permit can be suspended or revoked if any false information is supplied toward securing the permit/any unauthorized changes are made to the site/any unauthorized changes are made in the installation of the system

Improvement Permit is valid for 60 months from date of issuance.

Signed:

Improvement Permit by: STEVE HENDRICK date 6/15/92

Existing System Inspection by: date

Installed by: A-1 BACKHOE

Certificate of Completion by: STEVE HENDRICK date 6/16/93

Operation Permit by: date

HEALTH DEPT. COPY: WHITE INSPECTION COPY (FINAL): GREEN OWNER COPY (FINAL): YELLOW INSPECTION COPY (INITIAL): PINK OWNER COPY (INITIAL): GOLD