$125.00 PD

IREDELL COUNTY HEALTH DEPARTMENT

STATESVILLE 704-878-5305 CI MOORESVILLE 704-664-5281

IMPROVEMENT PERMIT / AUTHORIZATION TO CONSTRUCT / OPERATION PERMIT / EXISTING SYSTEM INSPECTION

PERMIT# 102268 PIN# 4725-85-0605 DATE 9/20/01

OWNER OR CONTRACTOR Ronald Carter PHONE Business (803)366-4693 Home ~~(704)~~ (704) 878-6333

ADDRESS 130 Blue Jay Way Statesville N.C. 28625

LOCATION Monticello Rd, turn (R) Meadowlark, (R) Blueway Way on Left at End. End Anderson

SUBDIVISION Audubon BLOCK / SECTION — LOT 32 LOT AREA .71 Ac SITE CLASS IV DESIGN FLOW 360 L.T.A.R. .30

Septic Tank: 1,000 Gallons: STB 1007 Date 3-3-02
Pump Tank: 1,000 Gallons: PT 274 Date 3-4-02
Pump Make: Little Giant Model 2EHCIM Serial No —
Nitrification Field: No Fields 1 Square Feet 1,200 Linear Feet 300'
No Lines 4 Trench Width 36" Max Trench Bottom Depth 36" Gravel Depth —

X New System Repair System Type: I II III IV V VI
System Description: Pump, 25% Reduction
Repair System Description: Pump, 50% Reduction
Maintenance Agreement Required: Yes X No


X House/Mod. Home No. Bedrooms 4
Mobile Home No. Bathrooms 2½
Business No. Employees
Other
Slab Crawl Space Basement w/plumbing X Basement wo/plumbing

Water Supply: ☐ Individual X Public ☐ Community


Comments/Conditions: ① Install 25% Reduction System - 50 chambers or 30-10' HDES Sections on contour ② maintain required Setbacks ③ Do not install when wet

Comments/Conditions: Installed 400' of HDES Sections
Polylok Filter Installed
As-built Electrical OK 7/17/02

INITIAL SITE SKETCH 197' PL

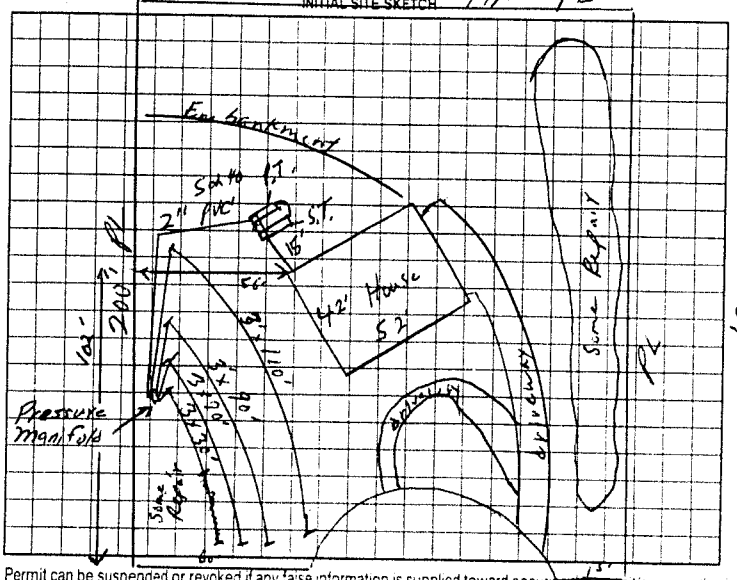

AS BUILT SKETCH

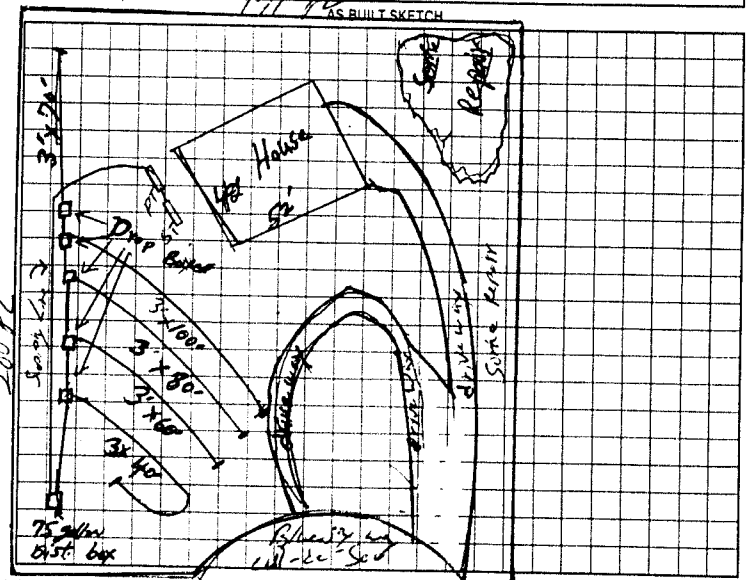

Permit can be suspended or revoked if any false information is supplied toward securing the permit, any unauthorized changes are made to the site any unauthorized changes are made in the installation of the system. Improvement Permit with plat valid without expiration. Improvement Permit with site plan valid for sixty months. Authorization to Construct is valid for a period equal to that of Improvement Permit - not to exceed sixty months.

Signed: [signature] date 9/20/01 Installed by: James Rusler

Improvement Permit by: William C. Johnson date 9/20/01 Operation Permit by: William C. Johnson date 7/17/02

Authorization to Construct by: William C. Johnson date 9/20/01 Existing System inspection by: _____ date _____

HEALTH DEPT COPY WHITE OWNER COPY (FINAL) YELLOW OWNER COPY (INITIAL) PINK