50084

IREDELL COUNTY HEALTH DEPARTMENT

STATESVILLE 704-878-5305 MOORESVILLE 704-664-5281

IMPROVEMENT PERMIT / CERTIFICATE OF COMPLETION / OPERATION PERMIT / EXISTING SYSTEM INSPECTION

PROPERTY DESCRIPTION NO. 17721 ~~6K-A-8A~~ DATE 1/21/94 TAX MAP NO. 6K-A-8A Watershed: ☐ Yes ☑ No

OWNER OR CONTRACTOR EARL L. ANDERSON PHONE: Business 872-8178 Home

ADDRESS 453 HUMMINGBIRD LANE, STVL NC 28677

LOCATION NC 90 W TR MONTICELLO, TL MEADOW LARK TR BLUEJAY WAY, LONG DRIVE AT END TO (H)

SUBDIVISION AUDUBON ACRES BLOCK / SECTION LOT LOT AREA 18 ACRES SITE CLASS. PS DESIGN FLOW 480 L.T.A.R. 0.30 GPD/FT²

Septic Tank: 1000 Gallons; STB 794 Date 3/7/94

Pump Tank: Gallons; PT Date

Pump Make: Model Serial No.

Nitrification Field: No Fields 1 Square Feet 1599 Linear Feet 533

No Lines 5 Trench Width 36" Max Trench Bottom Depth 24" Gravel Depth 12"

☑ New System ☐ Repair System Type: I, II, III, IV, V, VI

System Description: CONV, GRAVITY

Repair System Description:

Maintenance Agreement Required: ☐ Yes ☑ No

☑ House/Mod. Home No. Bedrooms 4

☐ Mobile Home No. Bathrooms 3½

☐ Business No. Employees

☐ Other


☐ Slab ☐ Crawl Space ☐ Basement w/plumbing ☑ Basement wo/plumbing

Water Supply: ☐ Individual ☐ Community ☑ Public


Comments: (1) KEEP SYSTEM MINIMUM 15' FROM BASEMENT, 10' FROM PROPERTY LINE, 50' FROM POND (2) INSTALL LINES ON CONTOUR NO DEEPER THAN 24", 9' ON CENTER, (3) USE 'DROP BOX DISTRIBUTION'.

Comments:

INITIAL SITE SKETCH

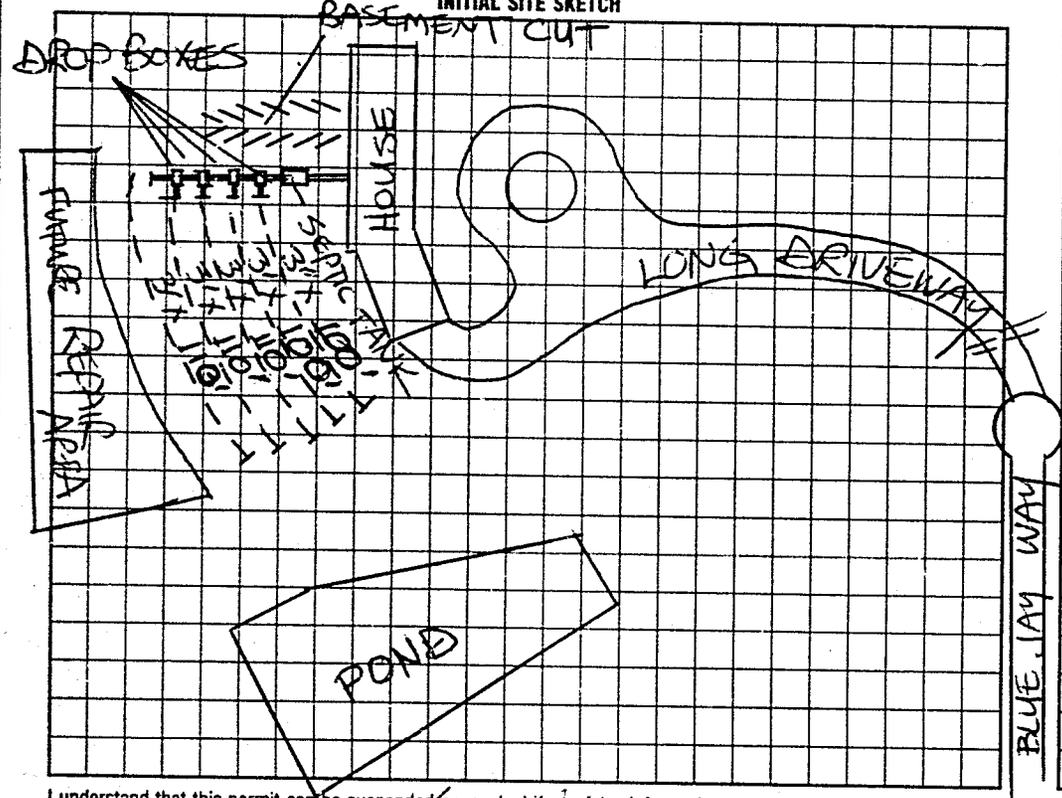

AS BUILT SKETCH

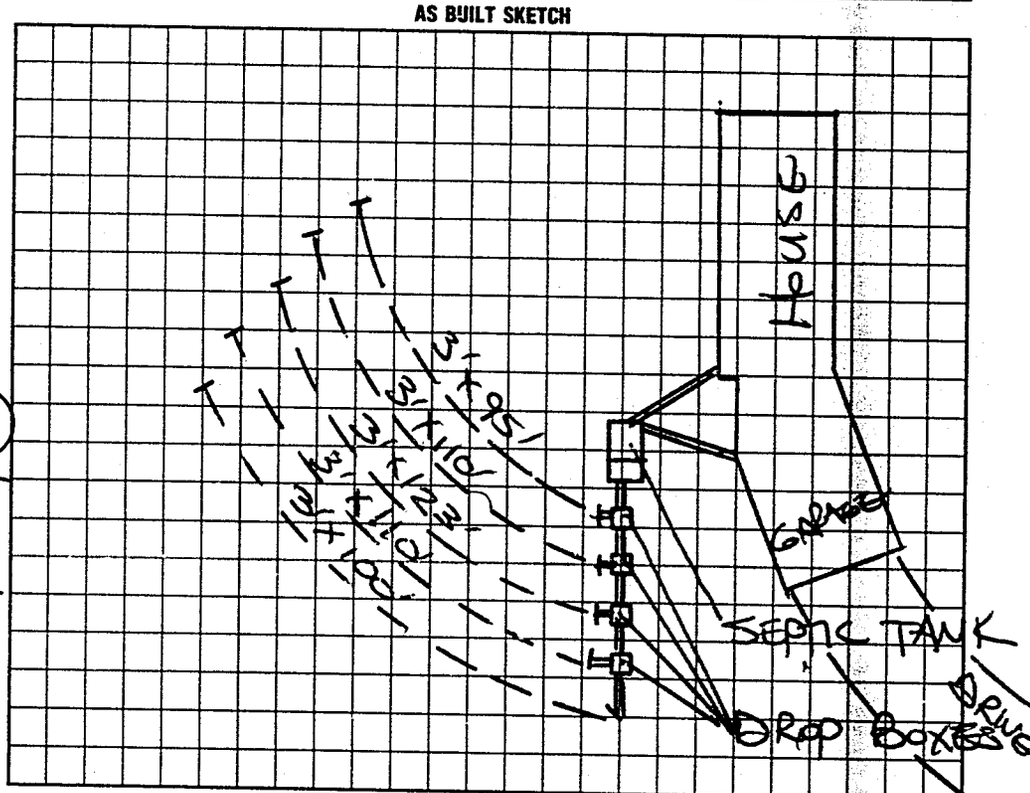

I understand that this permit can be suspended or revoked if any false information is supplied toward securing the permit/any unauthorized changes are made to the site/any unauthorized changes are made in the installation of the system. Improvement Permit is valid for 60 months from date of issuance.

Signed: [signature]

Improvement Permit by: STEVE HEDRICK date 1/21/94

Existing System Inspection by: date

Installed by: JAMES HUDLER

Certificate of Completion by: STEVE HEDRICK date 5/17/95

Operation Permit by: date

HEALTH DEPT. COPY: WHITE INSPECTION COPY (FINAL): GREEN OWNER COPY (FINAL): YELLOW INSPECTION COPY (INITIAL): PINK OWNER COPY (INITIAL): GOLD

698200