IREDELL COUNTY HEALTH DEPARTMENT

STATESVILLE 704-878-5305 MOORESVILLE 704-664-5281

IMPROVEMENT PERMIT / AUTHORIZATION TO CONSTRUCT / OPERATION PERMIT / EXISTING SYSTEM INSPECTION

PERMIT# _____ PIN# 4725-86-1666 DATE 11-7-08

OWNER OR APPLICANT EARL ANDERSON PHONE: Business 704-878-0333 Home 704-881-2953

ADDRESS 130 BLUE JAY WAY STATESVILLE NC 28625

LOCATION MONTICELLO ROAD, TO MEADOWLARK LANE, TR BLUE JAY WAY, TO END

SUBDIVISION AUDUBON ACRES BLOCK / SECTION _____ LOT 15 LOT AREA 18 ACRES SITE CLASS. PB DESIGN FLOW 480 L.T.A.R. 0.30 GPD/FT2

Septic Tank: 1000 Gallons; STB 794 Date 3/7/94

Pump Tank: _____ Gallons; PT _____ Date _____

Pump Make: _____ Model _____ Serial No. _____

Nitrification Field: No Fields 1 Square Feet 1600 Linear Feet 533

No Lines 5 Trench Width 36" Max Trench Bottom Depth 24" Gravel Depth 12" ☒ Gravity ☐ Pressure

☐ New System ☐ Repair ☐ Expansion System Type: I ☒ II III IV V VI

System Description: CONVENTIONAL GRAVITY

Repair System Description: CONV. GRAVITY

Maintenance Agreement Required: ☐ Yes ☒ No

☒ House/Mod. Home No. Bedrooms 4

☐ Mobile Home No. Persons _____

☐ Business No. Employees _____

☐ Other _____

Water Supply: ☐ Individual ☒ Public ☐ Community


☐ Slab ☐ Crawl Space ☐ Basement w/plumbing ☒ Basement wo/plumbing

Comments:/Conditions:

Comments:/Conditions: NEW BUILDING MINIMUM 5' FROM SYSTEM AS SHOWN

INITIAL SITE SKETCH

AS BUILT SKETCH

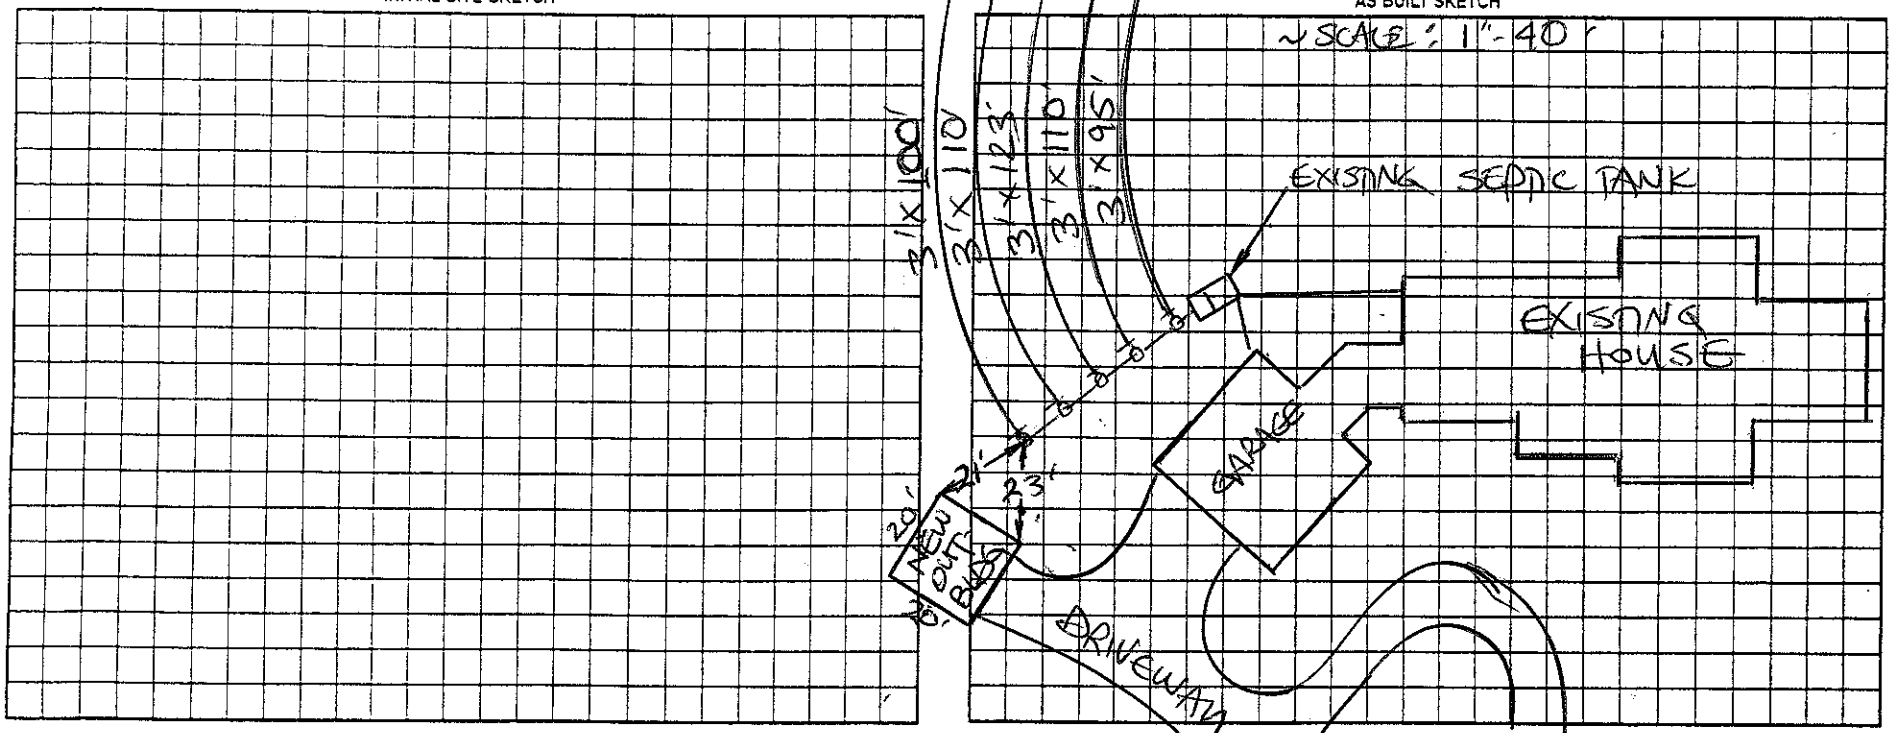

Permit can be suspended or revoked if any false information is supplied toward securing the permit/any unauthorized changes are made to the site/any unauthorized changes are made in the installation of the system. Improvement Permit with plat valid without expiration ☐ Improvement Permit with site plan valid for sixty months ☐ Authorization to Construct is valid for a period equal to that of Improvement Permit – not to exceed sixty months.

Signed: _____ date _____ Installed by: _____

Improvement Permit by: _____ date _____ Operation Permit by: _____ date _____

Authorization to Construct by: _____ date _____ Existing System Inspection by: STEVE HEDRICK date 11-7-08

HEALTH DEPT. COPY: WHITE OWNER COPY (FINAL): YELLOW OWNER COPY (INITIAL): PINK