IREDELL COUNTY HEALTH DEPARTMENT

STATESVILLE 704-878-5305 MOORESVILLE 704-664-5281

IMPROVEMENT PERMIT / AUTHORIZATION TO CONSTRUCT / OPERATION PERMIT / EXISTING SYSTEM INSPECTION

PERMIT# REPAIR PIN# 4725-94-1617 DATE 6-6-05

OWNER OR CONTRACTOR MARTIN MARIETTA MATERIALS PHONE: Business Home (704) 878-0740

ADDRESS P.O. BOX 18565 GREENSBORO NC 27419

LOCATION NC 115 NORTH, TL OLD WILKESBORO RD, TL BRADLEY FARM ROAD, 0.5 MILE ON LEFT AT #247

SUBDIVISION BLOCK / SECTION LOT LOT AREA 1.61 ACRES SITE CLASS. PS DESIGN FLOW 485 L.T.A.R. 0.30 GPD/FT²

Septic Tank: EXISTING Gallons; STB Date

Pump Tank: Gallons; PT Date

Pump Make: Model Serial No.

Nitrification Field: No Fields 1 Square Feet 540 Linear Feet 180

No Lines TWO Trench Width 36" Max Trench Bottom Depth 36" Gravel Depth (18")

☐ New System ☑ Repair System Type: I (II) III, IV, V, VI

System Description: CONVENTIONAL, GRAVITY

Repair System Description: CONVENTIONAL, GRAVITY

Maintenance Agreement Required: ☐ Yes ☑ No

☑ House/Mod. Home No. Bedrooms 1

☐ Mobile Home No. Bathrooms

☑ Business No. Employees

☑ Other W/ONE CHAIR BEAUTY PARLOR


☐ Slab ☐ Crawl Space ☑ Basement w/plumbing ☐ Basement wo/plumbing

Water Supply: ☐ Individual ☑ Public ☐ Community


Comments:/Conditions: INSTALL TWO NEW DRAINLINES AS SHOWN USING 18" STONE

Comments:/Conditions: NEW SANITARY TEE INSTALLED IN SEPTIC TANK

INITIAL SITE SKETCH

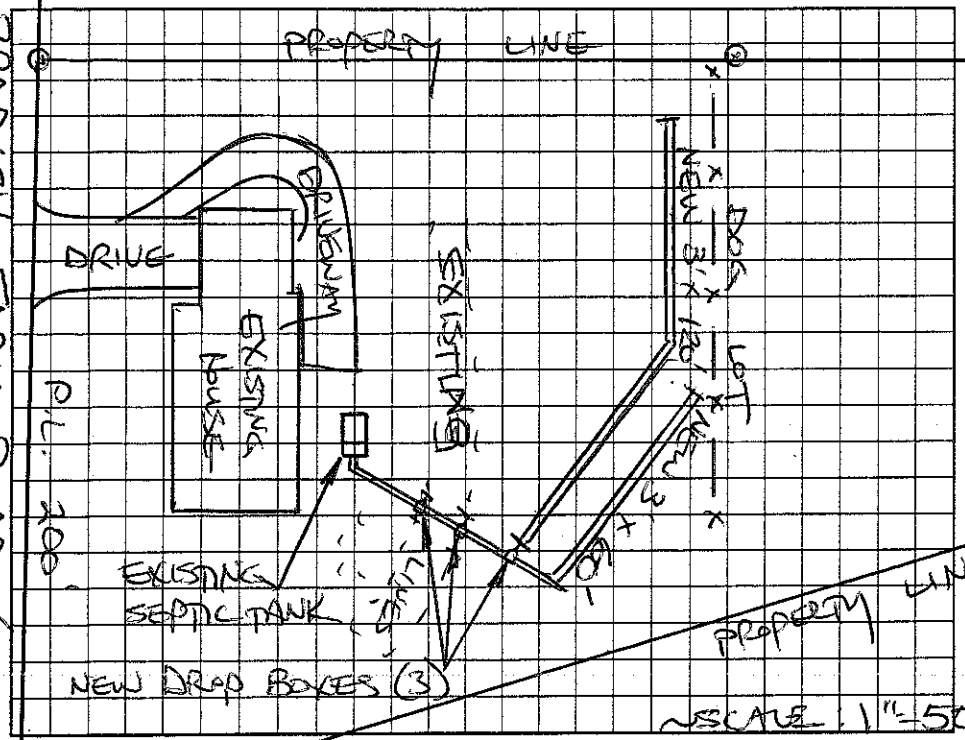

AS BUILT SKETCH

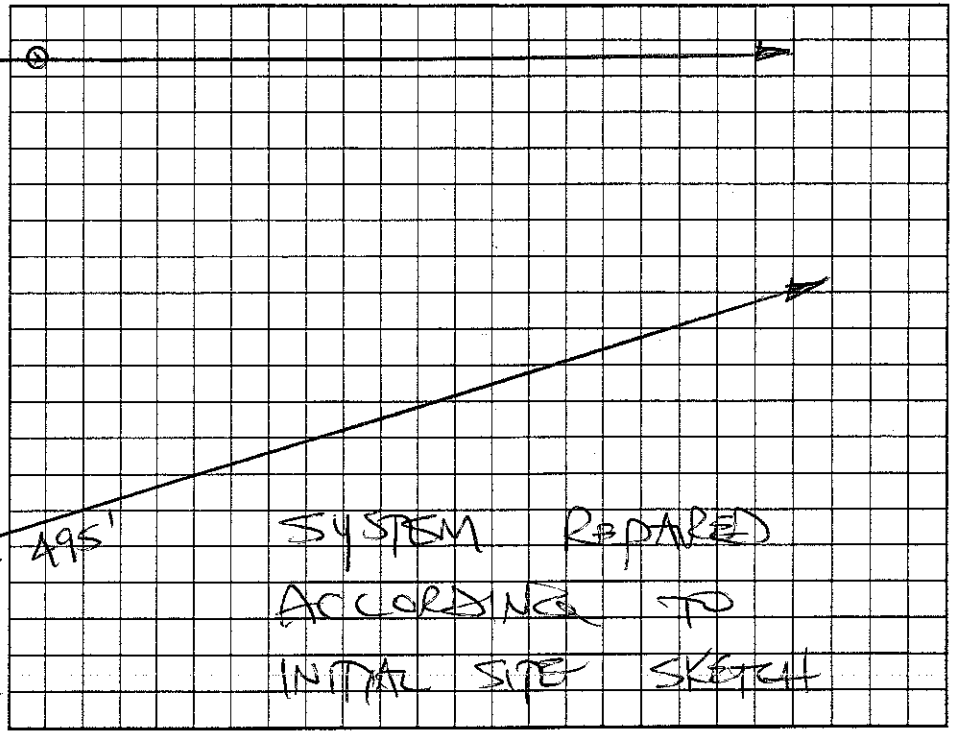

Permit can be suspended or revoked if any false information is supplied toward securing the permit/any unauthorized changes are made to the site/any unauthorized changes are made in the installation of the system. Improvement Permit with plat valid without expiration. Improvement Permit with site plan valid for sixty months. Authorization to Construct is valid for a period equal to that of Improvement Permit – not to exceed sixty months.

Signed: date 6/6/05 Installed by: JAMES HUDER

Improvement Permit by: STEVE HEDRICK date 6-6-05 Operation Permit by: STEVE HEDRICK date 6-6-05

Authorization to Construct by: STEVE HEDRICK date 6-6-05 Existing System Inspection by: date

HEALTH DEPT. COPY: WHITE OWNER COPY (FINAL): YELLOW OWNER COPY (INITIAL): PINK