IREDELL COUNTY HEALTH DEPARTMENT

Statesville Office (704) 878-5305 Mooresville Office (704) 660-3625 PERMIT # 201845

IMPROVEMENT PERMIT / AUTHORIZATION TO CONSTRUCT / OPERATION PERMIT / EXISTING SYSTEM

PIN # 4725952389

APPLICANT: John Dunn APPLICANT ADDRESS: 171 Monticello Dr.

SITE ADDRESS: 171 Monticello Dr. PHONE: 704-657-5784 ALT. PHONE: N/A

SITE DIRECTIONS: Hwy 115 N TL old Wilkesboro Hwy TL Monticello Dr.

SUBDIVISION: C Dave Pope SECTION: BLKA LOT # 1 LOT AREA: 0.57 acres DESIGN FLOW: 360gpd L.T.A.R.: 0.2

Septic Tank 1000 (gal) STB 760-1000 Date 8-13
Pump Tank (gal) PT Date
Pump Make Model Serial #
Nitrification Fields 1 # Lines 4 Linear Ft: 296
Trench Width 36" Max. Trench Bottom Depth 36" Gravel Depth N/A


☐ New System ☑ Repair ☐ Expansion System Type: I II III IV V VI
System Description:
Repair System Description: 2590 Reduction
Maintenance Agreement Required: ☐ YES ☑ NO
☑ GRAVITY ☐ PRESSURE

☑ Residence No. Bedrooms 3
☐ Business No. Persons 6
☐ Other No. Employees
☐ Slab ☑ Crawl Space
☐ Basement w/plumbing ☐ Basement w/o plumbing

Water Supply
☐ Private
☑ Public
☐ Community

Comments / Conditions: Install a new septic tank @ location shown below. Install a 2580 Reduction system on contour with serial distribution. Install surface diversion ditches at locations shown below. It is recommended that Pin Oak trees be removed from sewage area. Pump & crush existing septic tank.

INITIAL SITE SKETCH

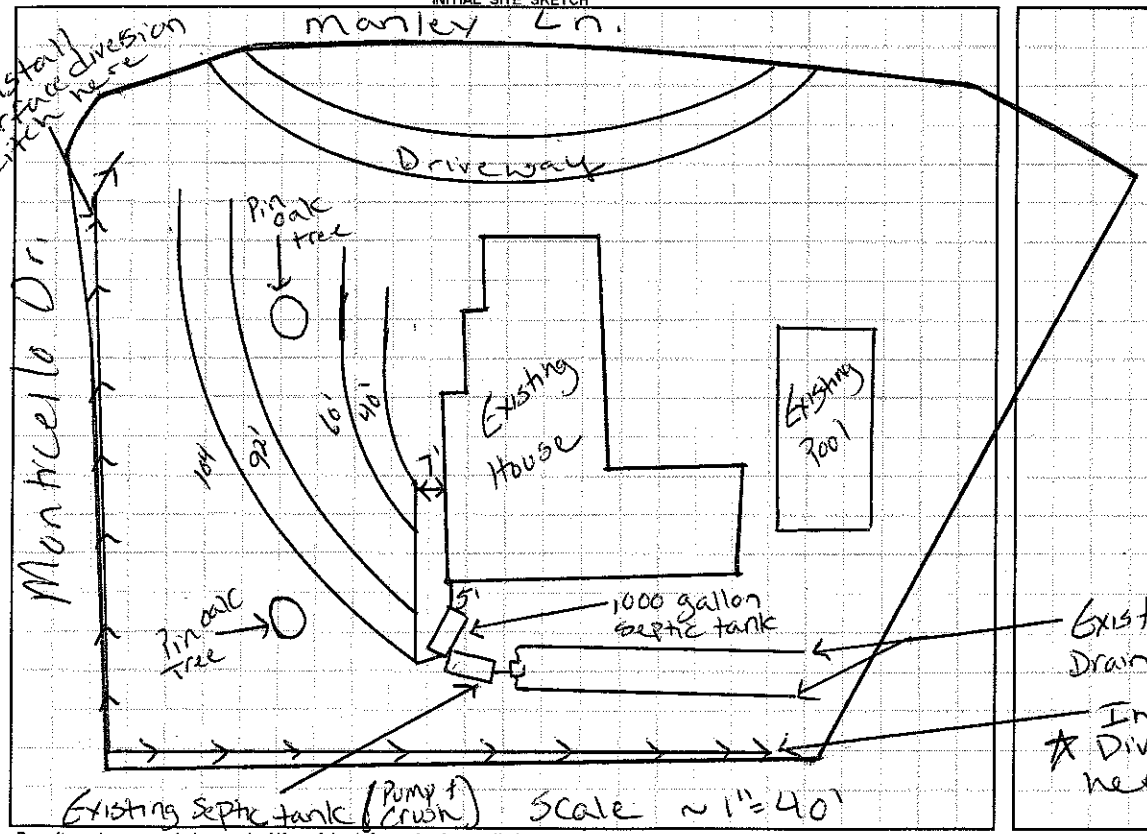

AS BUILT SKETCH

- Red polylok filter installed
- 2 use 50 installed over septic tank
- Quick 4 Chambers Installed

Permit can be suspended or revoked if any false information is supplied toward securing the permit / any unauthorized changes are made to the site / any unauthorized changes are made in the installation of the system. **CONTACT A LOCATOR SERVICE PRIOR TO ANY EXCAVATION**

☐ **IMPROVEMENT PERMIT** *with plat valid without expiration.* ☑ **IMPROVEMENT PERMIT** *with site plan valid for 60 mos.* ☑ **AUTHORIZATION TO CONSTRUCT** *valid for period equal to IMPROVEMENT PERMIT--not to exceed 60 mo.*

Owner / Applicant Signature: Date: 2-27-14 Installed by: A-1 Backhoe

IMPROVEMENT PERMIT by: Date: 2-27-14 OPERATION PERMIT by: Date: 4-1-14

AUTHORIZATION TO CONSTRUCT by: Date: 2-27-14 Existing System Inspected by: Date:

Health Dept. Copy - WHITE Applicant (Final Approval) - YELLOW Applicant (Conditional Approval) - PINK