IREDELL COUNTY HEALTH DEPARTMENT

Statesville Phone TR 3-7271 Mooresville Phone NO 3-1271

PERMIT TO INSTALL SEPTIC TANK

Permit No. _____ Permit Date Aug 25 1964

Owner M. Eric Pharr Address Statesville

Installed By Roy Lentz Address Statesville


Location of Property Go Out Wilkesboro Rd. Turn on to Montevallo Drive Short Dist. on Right

Tank		Capacity		Length of Lines		Fixtures	
Block	( )	1000	(✓)	225'	(✓)	No. of Baths	(1½)
Precast	( )	1250	( )	250'	( )	Dishwasher	( )
Pond	✓	1500	( )	Other _____		Garbage Grdr.	( )
		Other _____				Other _____	

NOTIFY HEALTH DEPARTMENT AT LEAST EIGHT HOURS BEFORE TANK IS TO BE INSPECTED.

Final Inspection 8-25 1964 Approved (✓) ~~Disapproved~~ ( )

Remarks _____

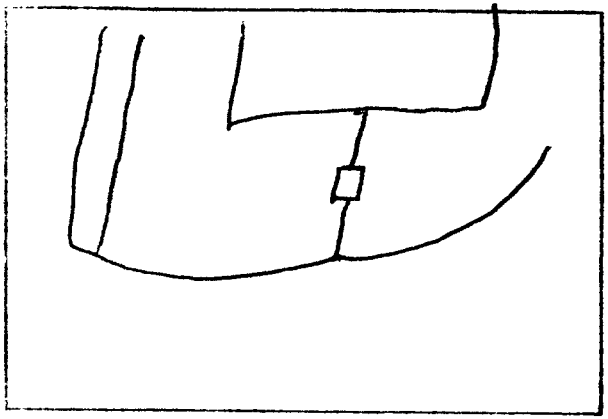

Sketch of Installation

Sanitarian