# IREDELL COUNTY HEALTH DEPARTMENT

STATESVILLE 704-878-5305 MOORESVILLE 704-664-5281

## IMPROVEMENT PERMIT / CERTIFICATE OF COMPLETION / OPERATION PERMIT / EXISTING SYSTEM INSPECTION

PROPERTY DESCRIPTION NO. REPAIR DATE 4/28/94 TAX MAP NO. REPAIR Watershed: ☐ Yes ☒ No

OWNER OR CONTRACTOR RICK MENSCER PHONE: Business 873-6312 Home 585-2605

ADDRESS RT. 13, BOX 180 STVL NC 28677

LOCATION NC 90 W, TR MONTICELLO, TR MANELL, TL BANCROFT, 2ND HOUSE ON (L)

SUBDIVISION _____ BLOCK / SECTION _____ LOT _____ LOT AREA AMPLE SITE CLASS PS DESIGN FLOW 360 L.T.A.R. EXISTING

Septic Tank: EXISTING Gallons; STB _____ Date _____

Pump Tank: _____ Gallons; PT _____ Date _____

Pump Make: _____ Model _____ Serial No. _____

Nitrification Field: No Fields 2 Square Feet 300 Linear Feet 100

No Lines 1 Trench Width 36" Max Trench Bottom Depth 36" Gravel Depth 18"

☒ New System ☐ Repair System Type: I, (II), III, IV, V, VI

System Description: CONVENTIONAL GRAVITY

Repair System Description: CONVENTIONAL GRAVITY

Maintenance Agreement Required: ☐ Yes ☒ No

☒ House/Mod. Home ☐ Mobile Home ☐ Business ☐ Other

No. Bedrooms 3 No. Bathrooms 1 No. Employees _____


☐ Slab ☒ Crawl Space ☐ Basement w/plumbing ☐ Basement wo/plumbing

Water Supply: ☒ Individual ☐ Community ☐ Public WELL


Comments: (1) KEEP SYSTEM MINIMUM 5' FROM HOUSE, 50' FROM WELL, 10' FROM PROPERTY LINE. (2) INSTALL NEW SANITARY TEE IN TANK. (3) INSTALL NEW DIST. BOX AS SHOWN.

Comments:

### INITIAL SITE SKETCH

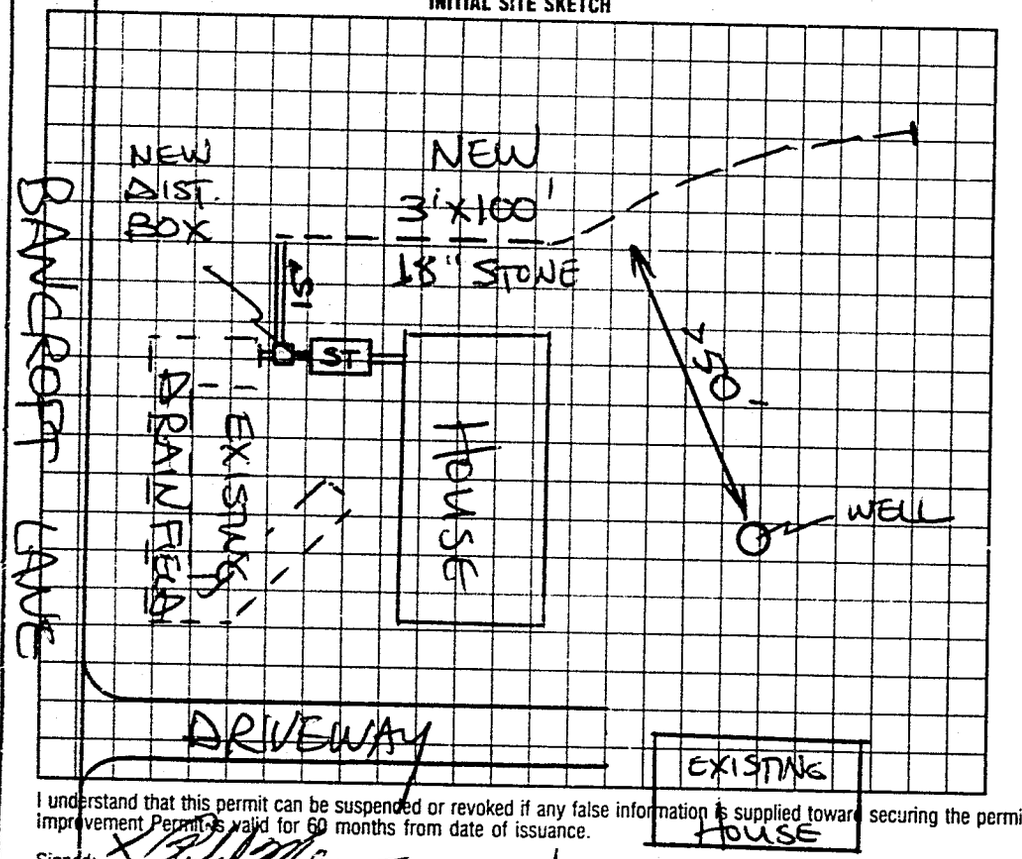


### AS BUILT SKETCH

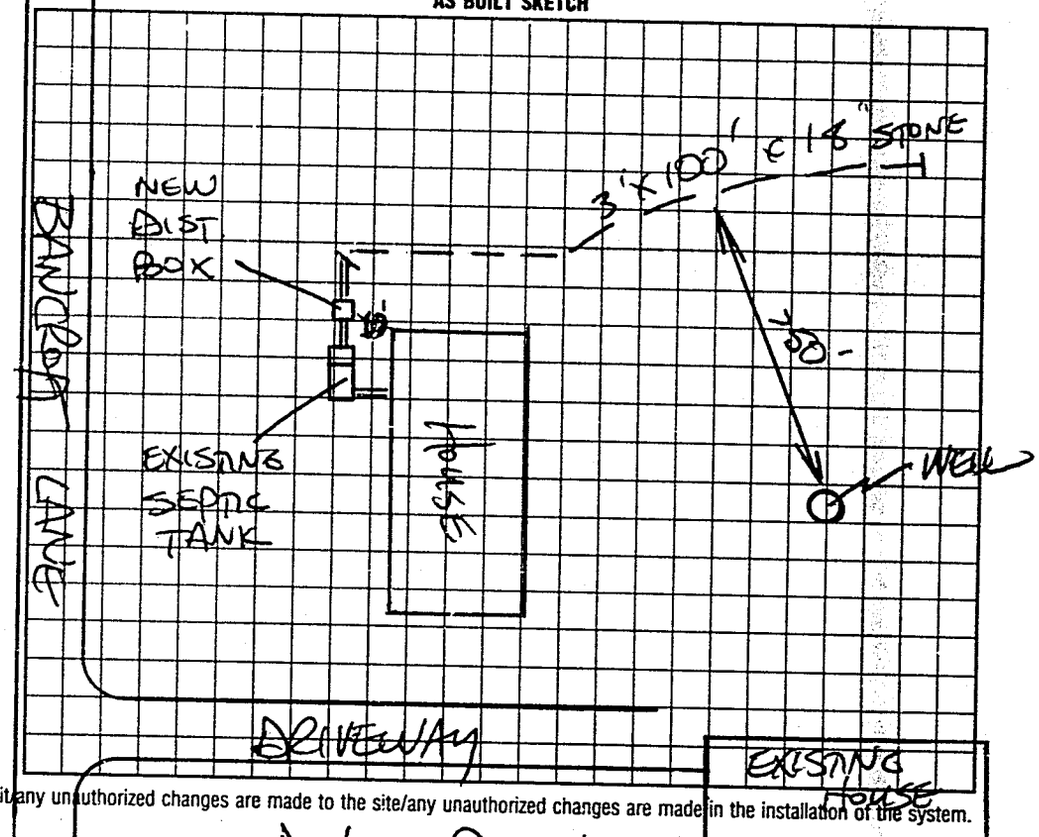


I understand that this permit can be suspended or revoked if any false information is supplied toward securing the permit, any unauthorized changes are made to the site/any unauthorized changes are made in the installation of the system. Improvement Permit is valid for 60 months from date of issuance.

Signed: X _____

Improvement Permit by: STEVE HEDRICK date 4/28/94

System Inspection by: _____ date _____

Installed by: A-1 BACKHOE

Certificate of Completion by: STEVE HEDRICK date 5/25/94

Operation Permit by: _____ date _____

HEALTH DEPT COPY: WHITE INSPECTION COPY (FINAL): GREEN OWNER COPY (FINAL): YELLOW INSPECTION COPY (INITIAL): PINK OWNER COPY (INITIAL): GOLD