IREDELL COUNTY HEALTH DEPARTMENT

STATESVILLE 704-878-5305 MOORESVILLE 704-664-5281

IMPROVEMENT PERMIT / AUTHORIZATION TO CONSTRUCT / OPERATION PERMIT / EXISTING SYSTEM INSPECTION

PERMIT# Repair PIN# 4725959655 DATE 12-17-04

OWNER OR CONTRACTOR Jim Thompson PHONE: Business — Home (704) 873-8013

ADDRESS 131 Ivanhoe Lane Statesville N. C. 28625

LOCATION Hwy 115 N @ an Old Wilkesboro Rd. (2) on Montrello Rd; (3) on Ivanhoe Lane @ 131 Ivanhoe on Right

SUBDIVISION Thompson Property BLOCK / SECTION — LOT 9 LOT AREA ~1.25Ac. SITE CLASS. 15 DESIGN FLOW 240 L.T.A.R. Ex

Septic Tank: 1,000 Gallons; STB 1012 Date 7-18-04

Pump Tank: — Gallons; PT — Date —

Pump Make: — Model — Serial No. —

Nitrification Field: No Fields 1 Square Feet Ex Linear Feet Ex

No Lines 2 Trench Width — Max Trench Bottom Depth — Gravel Depth —

☐ New System ☒ Repair System Type: I, (II), III, IV, V, VI

System Description: Gravity, Conventional

Repair System Description: —

Maintenance Agreement Required: ☐ Yes ☒ No

☒ House/Mod. Home ☐ Mobile Home ☐ Business ☐ Other

No. Bedrooms 2 No. Bathrooms 1 No. Employees —


☐ Slab ☐ Crawl Space ☐ Basement w/plumbing ☐ Basement wo/plumbing

Water Supply: ☐ Individual ☒ Public ☐ Community


Comments/Conditions: (1) Crush + Fill old Tank (2) Set New 1,000 gallon Septic Tank (3) IF Existing lines are removed; replace footage with New line on Contour

Comments/Conditions (1) TUFF-TITE (2) 6" RISER ON TANK (3) #5 STONE

INITIAL SITE SKETCH

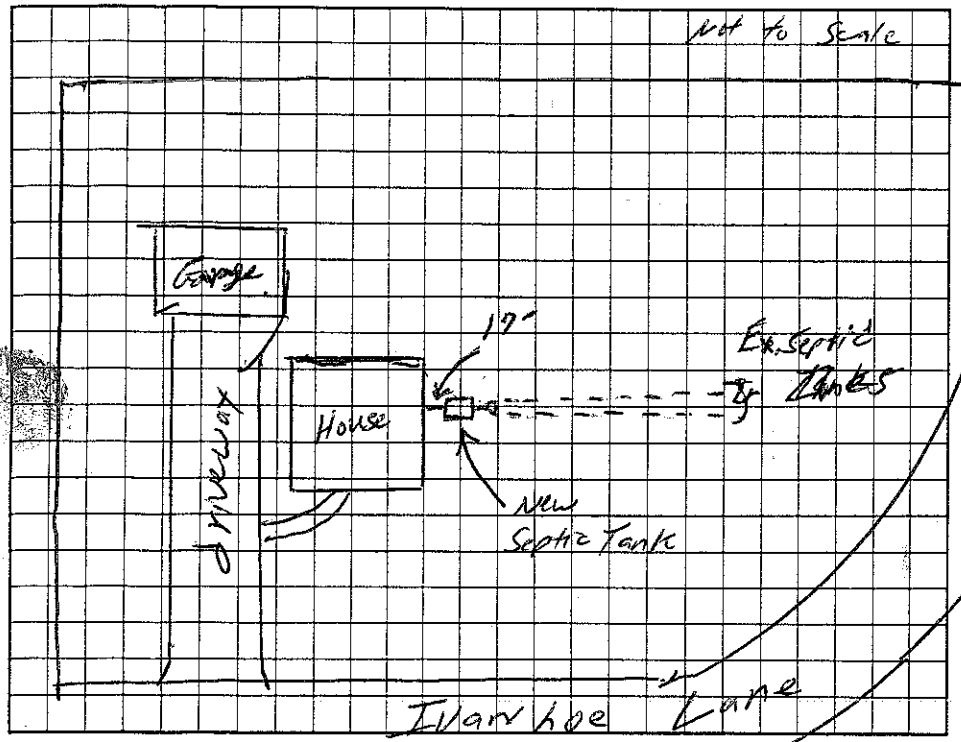

AS BUILT SKETCH

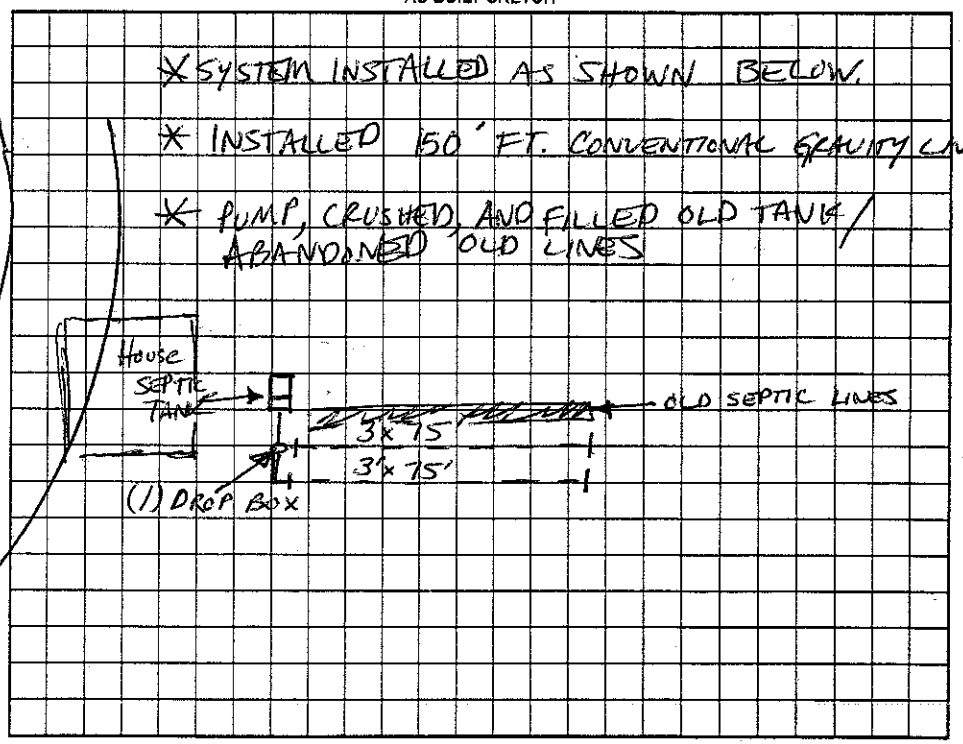

Permit can be suspended or revoked if any false information is supplied toward securing the permit/any unauthorized changes are made to the site/any unauthorized changes are made in the installation of the system. Improvement Permit with plat valid without expiration. Improvement Permit with site plan valid for sixty months. Authorization to Construct is valid for a period equal to that of Improvement Permit – not to exceed sixty months.

Signed: James T. Thompson date 12-17-04 Installed by: ANTHONY GEORGE

Improvement Permit by: [signature] date 12/17/04 Operation Permit by: Christopher M. [illegible] LHS, LSS date 1-20-05

Authorization to Construct by: [signature] date 12/17/04 Existing System Inspection by: — date —

HEALTH DEPT. COPY: WHITE OWNER COPY (FINAL): YELLOW OWNER COPY (INITIAL): PINK