52553

# IREDELL COUNTY HEALTH DEPARTMENT

STATESVILLE 704-878-5305 MOORESVILLE 704-664-5281

## IMPROVEMENT PERMIT / CERTIFICATE OF COMPLETION / OPERATION PERMIT / EXISTING SYSTEM INSPECTION

PROPERTY DESCRIPTION NO. 19254 DATE 9/2/94 TAX MAP NO. 9A-3-B-16/17 Watershed: ☐ Yes ☑ No

OWNER OR CONTRACTOR KIM JOHNSON PHONE: Business _____ Home _____

ADDRESS 225 FLATROCK LANE STATESVILLE NC 28677

LOCATION NC 115N, TL OLD WILKESBORO RD, TL FLATROCK LANE, 2ND HOUSE ON (L) PAST CURVE

SUBDIVISION LONE PINE HEIGHTS BLOCK / SECTION _____ LOT 16/17 LOT AREA 100 x 150 SITE CLASS PS DESIGN FLOW EXISTING T.A.R. EXISTING

Septic Tank: EXISTING Gallons; STB _____ Date _____

Pump Tank: _____ Gallons; PT _____ Date _____

Pump Make: _____ Model _____ Serial No. _____

Nitrification Field: No Fields ____ Square Feet _____ Linear Feet EXISTING

No Lines _____ Trench Width _____ Max Trench Bottom Depth _____ Gravel Depth _____

☐ New System ☐ Repair System Type: I, II, III, IV, V, VI

System Description: CONV. GRAVITY

Repair System Description: _____

Maintenance Agreement Required: ☐ Yes ☑ No

☐ Slab ☐ Crawl Space ☐ Basement w/plumbing ☐ Basement wo/plumbing

☐ House/Mod. Home No. Bedrooms ____

☐ Mobile Home No. Bathrooms ____

☐ Business No. Employees ____


☐ Other POOL

Water Supply:
☐ Individual
☑ Community
☑ Public


Comments:

Comments: KEEP POOL MINIMUM 15' FROM ANY PART OF SEPTIC SYSTEM.

**INITIAL SITE SKETCH**

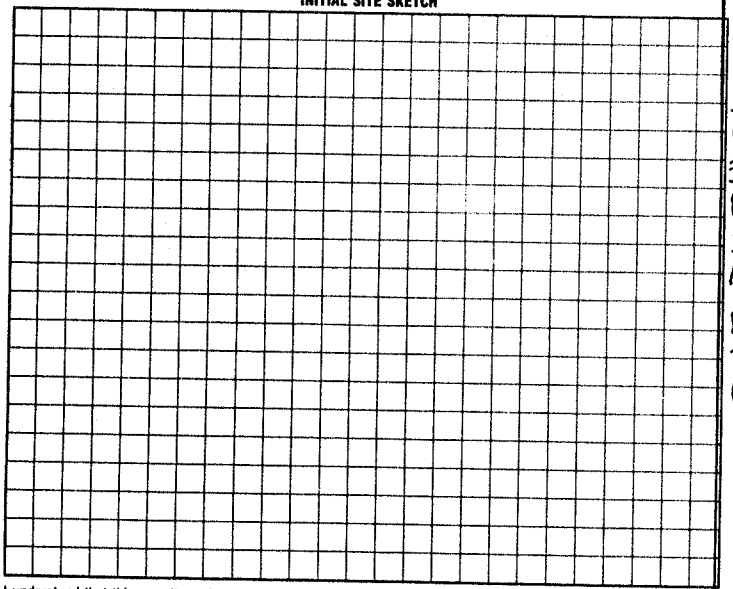


**AS BUILT SKETCH**

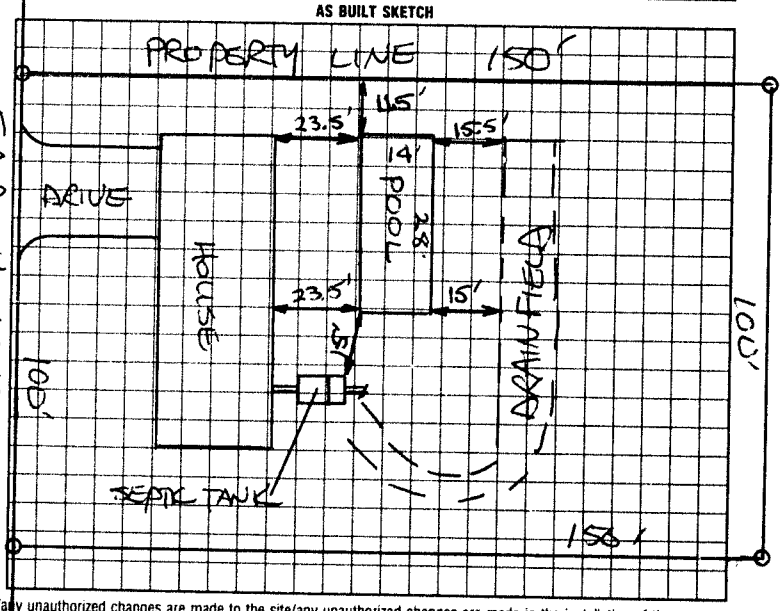


I understand that this permit can be suspended or revoked if any false information is supplied toward securing the permit/any unauthorized changes are made to the site/any unauthorized changes are made in the installation of the system. Improvement Permit is valid for 60 months from date of issuance.

Signed: _____

Improvement Permit by: _____ date _____

Existing System Inspection by: STEVE HENDRICK date 9/2/94

Installed by: _____

Certificate of Completion by: _____ date _____

Operation Permit by: _____ date _____

HEALTH DEPT. COPY: WHITE INSPECTION COPY (FINAL): GREEN OWNER COPY (FINAL): YELLOW INSPECTION COPY (INITIAL): PINK OWNER COPY (INITIAL): GOLD