IREDELL COUNTY HEALTH DEPARTMENT *ENVIRONMENTAL HEALTH DIVISION:*

SITE PLAN WORKSHEET

SEE THE "SAMPLE SITE PLAN" BELOW. ***INCOMPLETE SITE PLANS WILL BE RETURNED TO YOU FOR COMPLETION AND MAY RESULT IN A DELAY IN THE ISSUANCE OF YOUR SEPTIC SYSTEM PERMIT!!!***

Place an (X) beside each item as you complete the site plan:

_X_ Property Line measurements are clearly identified... **_____ All proposed structures are indicated...**

SHOW: proposed house or business footprint, wells, water lines, patios, pools and decks, and any other item that will occupy space on the site


_____ Front and side setbacks from property line... **_____ Preferred driveway location and configuration, preferred well location...**

_____ Area you prefer your septic system to be placed... **_____ North arrow, or other sufficient indicator of direction...**


Circle N/A on the following if appropriate:

_____ Location of septic systems and wells within 100' of your property... N/A

_____ Location of easements and rights of ways on your property... N/A **_____ Location of any designated wetlands on the property... N/A**

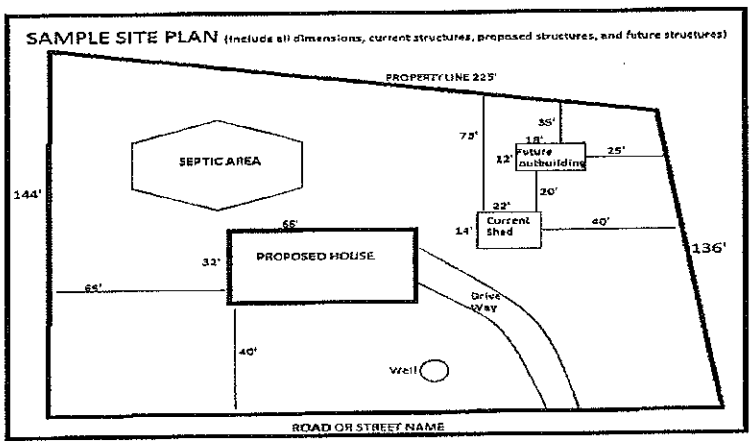

USE THIS SPACE TO DRAW YOUR SITE PLAN

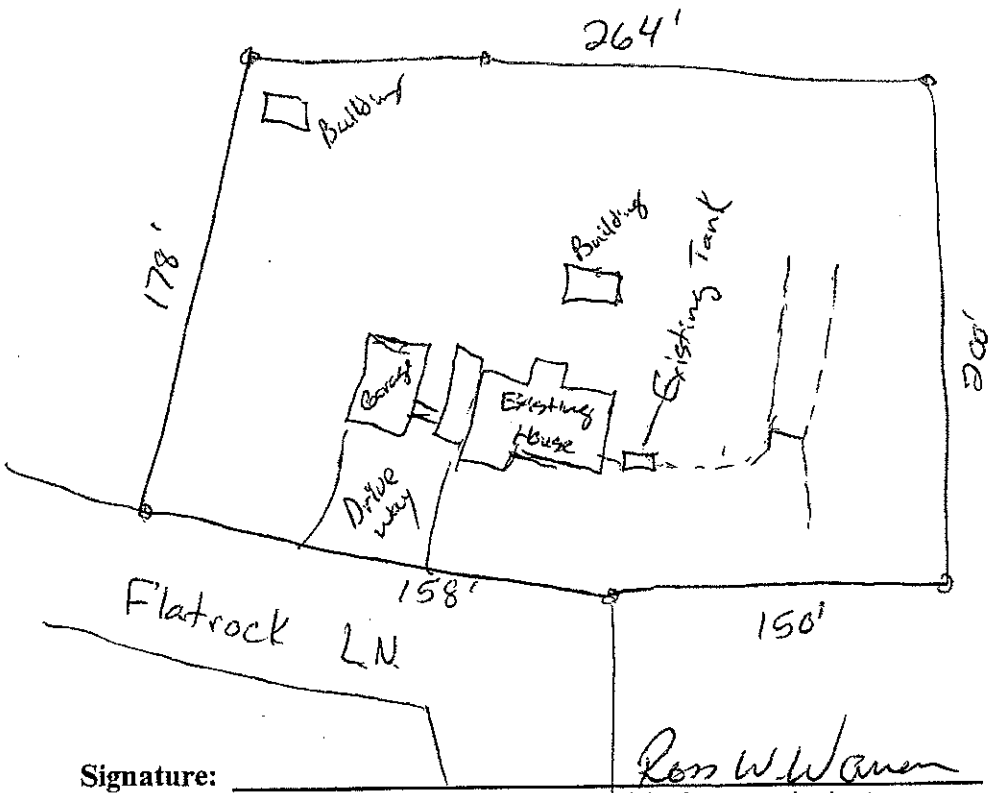

Signature: Ross W Warren

REQUIRED property owner or owner's legal representative signature.

10-2-2015

DATE

IREDELL COUNTY HEALTH DEPARTMENT

STATESVILLE 704-878-5305 MOORESVILLE 704-664-5281

IMPROVEMENT PERMIT / AUTHORIZATION TO CONSTRUCT / OPERATION PERMIT / EXISTING SYSTEM INSPECTION

PERMIT# REPAIR PIN# 4725 96 6509 DATE 1-28-00

OWNER OR CONTRACTOR JEFF & RHONDA TAYLOR PHONE. Business Home 871-1969

ADDRESS 113 FLATROCK LANE, STATESVILLE NC 28625

LOCATION NC 115 N, TL OLD WILKESBORO ROAD, TL FLATROCK LANE, HOUSE ON LEFT AT CURVE

SUBDIVISION BLOCK / SECTION LOT LOT AREA AMPLE SITE CLASS PS DESIGN FLOW 360 L.T.A.R. EXISTING

Septic Tank: EXISTING Gallons; STB Date

Pump Tank: Gallons; PT Date

Pump Make: Model Serial No.

Nitrification Field: No Fields 1 Square Feet 300 Linear Feet 100 FEET

No Lines ONE Trench Width 36" Max Trench Bottom Depth 36" Gravel Depth 24"

☐ New System ☒ Repair System Type: I, II, IV, V, VI

System Description: CONVENTIONAL GRAVITY

Repair System Description: CONVENTIONAL GRAVITY

Maintenance Agreement Required: ☐ Yes ☒ No

☒ House/Mod. Home No. Bedrooms 3

☐ Mobile Home No. Bathrooms 1

☐ Business No. Employees

☐ Other


☐ Slab ☒ Crawl Space ☐ Basement w/plumbing ☐ Basement wo/plumbing

Water Supply: ☐ Individual ☐ Public ☐ Community

Comments/Conditions: ① INSTALL NEW DROP BOX IN EXISTING DRAIN LINE ② INSTALL NEW 3'x 100' LINE USING 24" STONE ③ SYSTEM TO BE REPAIRED BY 2-29-00 ④ THIS PERMIT SERVES AS NOTICE OF VIOLATION

Comments/Conditions:

INITIAL SITE SKETCH

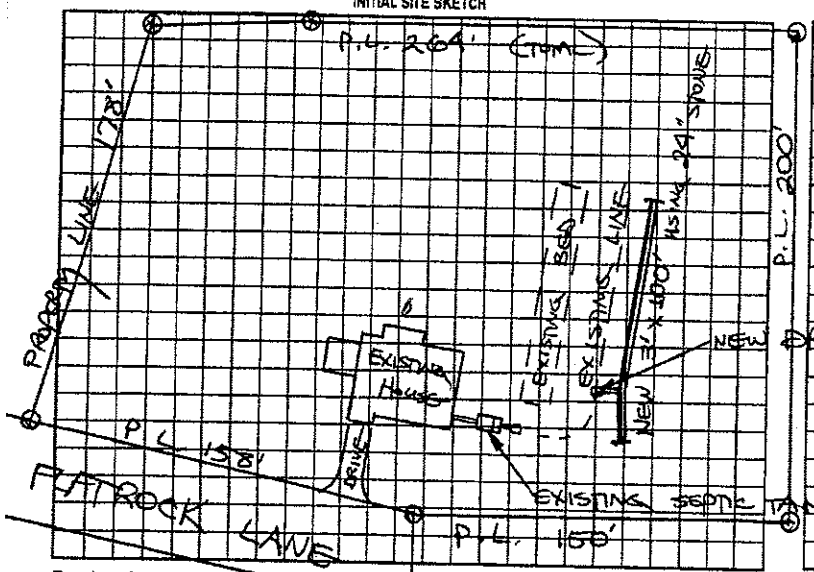

AS BUILT SKETCH

SYSTEM REPAIRED ACCORDING TO INITAL SITE SKETCH

Permit can be suspended or revoked if any false information is supplied toward securing the permit/any unauthorized changes are made to the site/any unauthorized changes are made in the installation of the system. Improvement Permit with plat valid without expiration. Improvement Permit with site plan valid for sixty months. Authorization to Construct is valid for a period equal to that of Improvement Permit – not to exceed sixty months.

Signed: T Keith 2-24-00 date 1-28

Improvement Permit by: STEVE HEDRICK date 1-28-00

Authorization to Construct by: STEVE HEDRICK date 1-28-00

Installed by: C & W GRADING

Operation Permit by: STEVE HEDRICK date 3-1-00

Existing System Inspection by: date

HEALTH DEPT. COPY: WHITE OWNER COPY (FINAL): YELLOW OWNER COPY (INITIAL): PINK

IREDELL COUNTY HEALTH DEPARTMENT

(SEPTIC TANK) IMPROVEMENTS PERMIT AND CERTIFICATE OF COMPLETION
(Ground Absorption Sewage Disposal System -- G. S. Chapter 130-Article 13C)

OWNER OR CONTRACTOR W.B. CROWSON DATE 6-28-90 PERMIT NO. _____

PHONE: Business _____ Home _____

LOCATION Hwy 115 N-T.L. on 115 to 1st st. past Monticello Dr., 1st house on left. S. R. No. _____


SUBDIVISION NAME _____ LOT NO. _____ SECTION OR BLOCK NO. _____

House (✓) Mobile Home ( ) Business ( ) Other Repair

No. Bedrooms _____ No. Bathrooms _____
Garbage Disposal Unit Yes ( ) No ( )
Auto. Dishwasher Yes ( ) No ( )
Auto. Wash. Machine Yes ( ) No (✓)
Site Suitable Yes (✓) No ( )
Lot Area Ample

Character & Porosity of Soil _____
Percolation Rate _____
Topography _____
Depth to Water Table Repair
Rock or other impervious formations _____

_____ Basement with Plumbing _____ Basement without Plumbing ✓ No Basement

 

Plot of System

Size of Tank EXISTING Gals.
Nitrification Field:
No. of Lines 4
Sq. Ft. 360 Linear Ft. 120
Depth of Stone in Line 12
Water Supply: Individual (✓)
Public ( )

Installed by Dennis Gallimore

I understand and agree to install septic tank system as specified on this Improvements Permit.

Signed: _____

IMPROVEMENTS PERMIT BY Glenn Fox & Steve Hedrick

COMMENTS: New tee installed Dist box set.

CERTIFICATE OF COMPLETION BY Steve Brewer DATE 6-28-90

EXISTING SYSTEM CHECKED BY: _____ DATE _____

CONSTRUCTION MUST COMPLY WITH ALL OTHER APPLICABLE STATE AND LOCAL REGULATIONS.

Permit is VOID if any unauthorized changes are made in installation of system and/or if any false information is supplied in making Improvements Permit.

Health Dept. Copy: White Inspection Dept. Copy: Yellow Sanitarian's Copy: Pink Owner's Copy: Gold