IREDELL COUNTY HEALTH DEPARTMENT

Statesville Office (704) 878-5305 Mooresville Office (704) 660-3625 PERMIT # 177040

IMPROVEMENT PERMIT / AUTHORIZATION TO CONSTRUCT / OPERATION PERMIT / EXISTING SYSTEM

PIN # 4725967739

APPLICANT: Barry Sechrist APPLICANT ADDRESS: 303 N. Center Street

SITE ADDRESS: 1989 Old Wilkesboro Rd. PHONE: 704-550-6612 ALT. PHONE: N/A


SITE DIRECTIONS: Hwy 115 N Turn Left old Wilkesboro Rd. Property on Left

SUBDIVISION: Long Pine Hts SECTION: N/A LOT # 1-6 LOT AREA: 0.55 acres DESIGN FLOW: 360 gpd L.T.A.R.: 0.3


Septic Tank 1000 (gal)	STB 760	Date 12-12	☐ New System ☑ Repair ☐ Expansion System Type: I II III IV V VI	☑ Residence	No. Bedrooms 3	Water Supply
Pump Tank (gal)	PT	Date	System Description:	☐ Business	No. Persons	☑ Private
Pump Make	Model	Serial #	Repair System Description: 25% Reduction	☐ Other	No. Employees	☐ Public
# Nitrification Fields 1	# Lines 4	Linear Ft: 272	Maintenance Agreement Required: ☐ YES ☑ NO	☐ Slab	☐ Crawl Space	☐ Community
Trench Width 36"	Max. Trench Bottom Depth 36"	Gravel Depth N/A	☑ GRAVITY ☐ PRESSURE	☐ Basement w/plumbing		☑ Basement w/o plumbing

Comments / Conditions: Install a 25% Reduction system on Contour with serial distribution. Check & replace Septic tank and/or tee, if needed. Use Supply Line of DUCTILE IRON at all areas it crosses under driveway. Remove any trees necessary to allow for system installation. It is recommended that all Maple trees be removed from nitrification field.

INITIAL SITE SKETCH

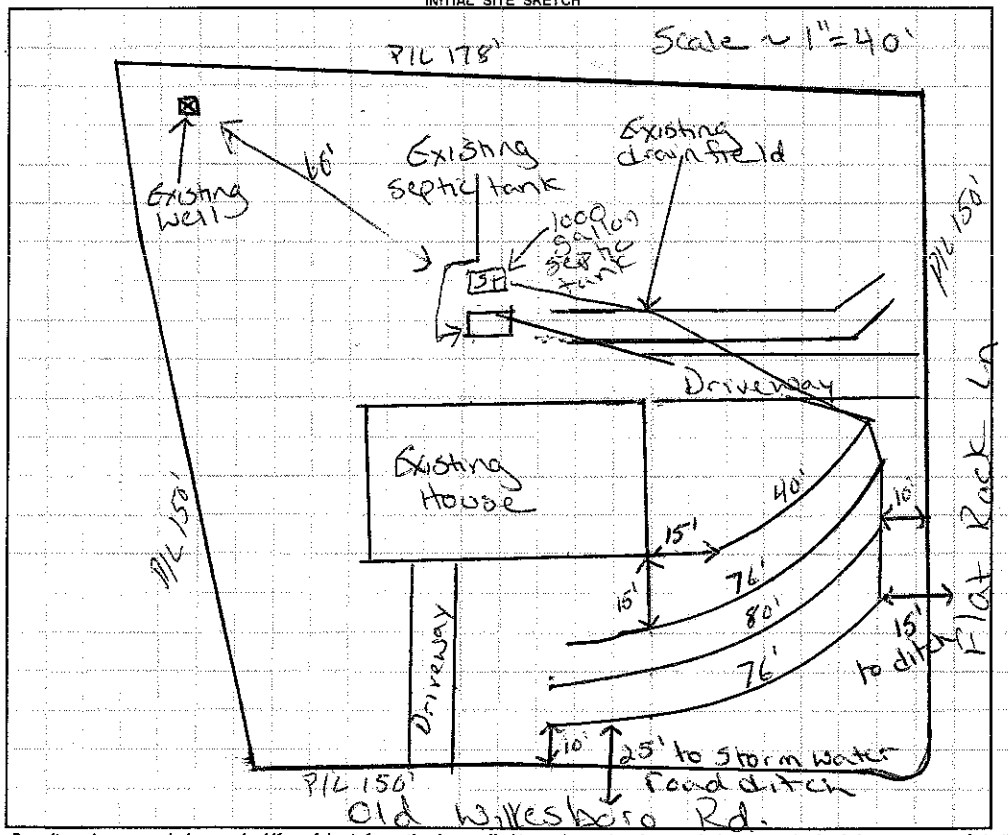

AS BUILT SKETCH

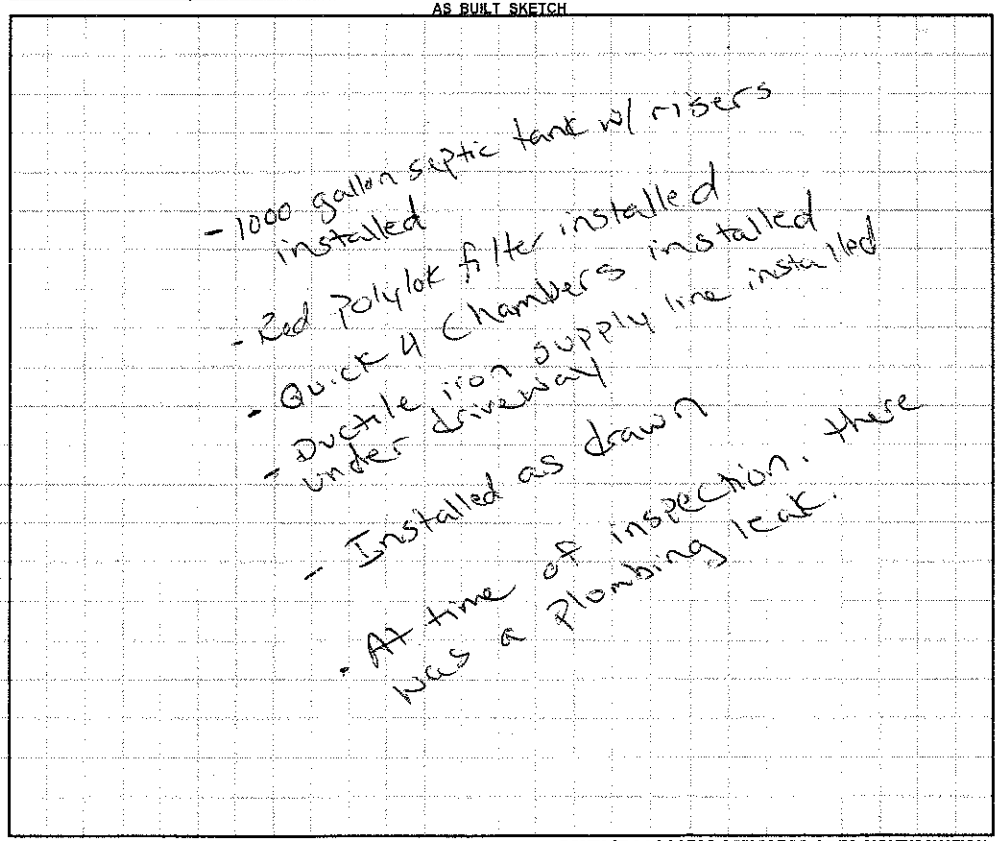

Permit can be suspended or revoked if any false information is supplied toward securing the permit / any unauthorized changes are made to the site / any unauthorized changes are made in the installation of the system. **CONTACT A LOCATOR SERVICE PRIOR TO ANY EXCAVATION**

☐ **IMPROVEMENT PERMIT** *with plat valid without expiration.* ☑ **IMPROVEMENT PERMIT** *with site plan valid for 60 mos.* ☑ **AUTHORIZATION TO CONSTRUCT** *valid for period equal to IMPROVEMENT PERMIT--not to exceed 60 mo.*

Owner / Applicant Signature: H. Barry Sechrist Date: 2-13-13 Installed by: J. Lentz

IMPROVEMENT PERMIT by: Justin Henderson Date: 2-13-13 OPERATION PERMIT by: Justin Henderson Date: 3-1-13

AUTHORIZATION TO CONSTRUCT by: Justin Henderson Date: 2-13-13 Existing System Inspected by: Date:

Health Dept. Copy - WHITE Applicant (Final Approval) - YELLOW Applicant (Conditional Approval) - PINK