Edward Shumaker

203833

IREDELL COUNTY HEALTH DEPARTMENT

STATESVILLE 704-878-5305 MOORESVILLE 704-664-5281

IMPROVEMENT PERMIT / AUTHORIZATION TO CONSTRUCT / OPERATION PERMIT / EXISTING SYSTEM INSPECTION

PERMIT# 128451 PIN# 4725968053 43 DATE 7-6-05

OWNER OR CONTRACTOR Edward Shumaker PHONE: Business 704-592-5813 Home

ADDRESS 291 Alcock Road, Statesville 28625

LOCATION 90 W to Monticello Rd, TR Monticello,

SUBDIVISION WD Morrison BLOCK / SECTION LOT 2&3 LOT AREA 1.738 AC SITE CLASS. PS DESIGN FLOW 360 L.T.A.R. .3

Septic Tank: 1000 Gallons; STB 825 Date 11-10-05

Pump Tank: Gallons; PT Date

Pump Make: Model Serial No.

Nitrification Field: No Fields 1 Square Feet 1200 Linear Feet 400

No Lines Trench Width 36" Max Trench Bottom Depth 30" Gravel Depth 12"

☒ New System ☐ Repair System Type: I, II, III, IV, V, VI

System Description: conv.

Repair System Description: conv.

Maintenance Agreement Required: ☐ Yes ☒ No

☒ House/Mod. Home No. Bedrooms 3

☐ Mobile Home No. Bathrooms

☐ Business No. Employees

☐ Other

☐ Slab ☑ Crawl Space ☐ Basement w/plumbing ☐ Basement wo/plumbing

Water Supply: ☐ Individual ☑ Public ☐ Community


Comments:/Conditions:

max trench depth 30"


Comments:/Conditions: Blue tag lite filter

1" = 60'

INITIAL SITE SKETCH

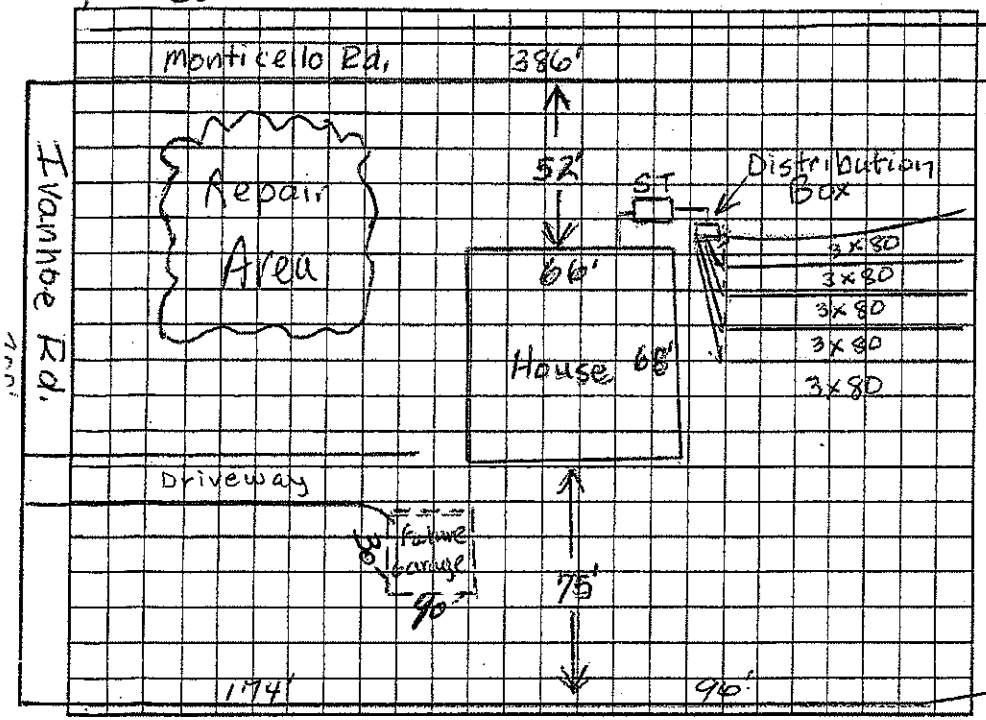

AS BUILT SKETCH

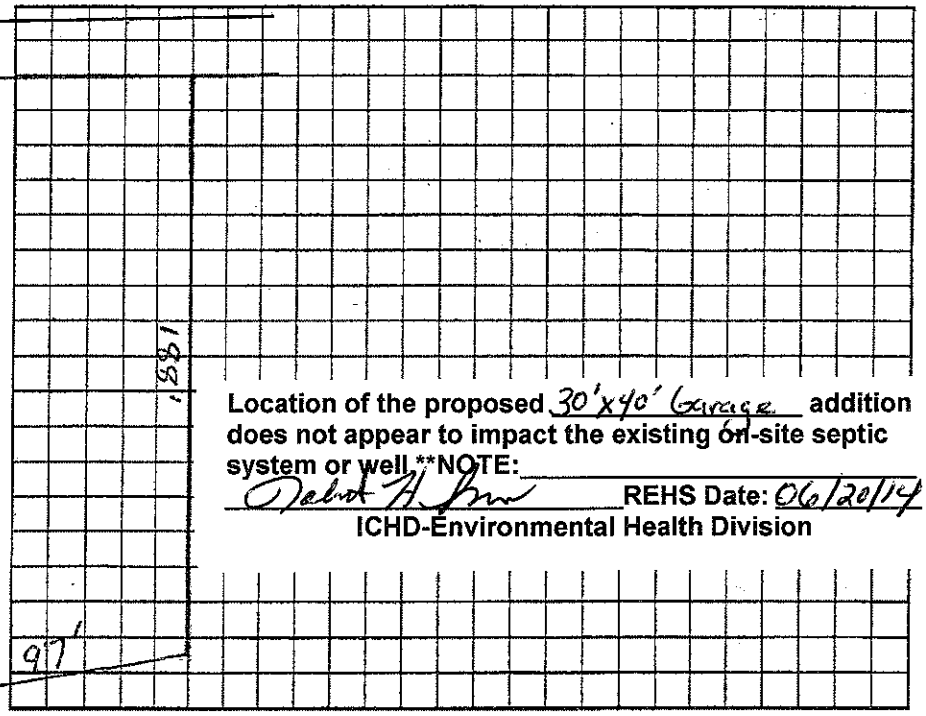

Location of the proposed 30'x40' Garage addition does not appear to impact the existing on-site septic system or well.**NOTE:

Debbie A. Lynn REHS Date: 06/20/14

ICHD-Environmental Health Division

Permit can be suspended or revoked if any false information is supplied toward securing the permit/any unauthorized changes are made to the site/any unauthorized changes are made in the installation of the system. Improvement Permit with plat valid without expiration. Improvement Permit with site plan valid for sixty months. Authorization to Construct is valid for a period equal to that of Improvement Permit – not to exceed sixty months.

Signed: Edward Shumaker date

Improvement Permit by: Judy Melville date 7-6-05

Authorization to Construct by: Judy Melville date 7-6-05

Installed by: Madison

Operation Permit by: Rusty Cook date 1-31-06

Existing System Inspection by: date

HEALTH DEPT. COPY: WHITE OWNER COPY (FINAL): YELLOW OWNER COPY (INITIAL): PINK