IREDELL COUNTY HEALTH DEPARTMENT

Statesville Office (704) 878-5305 Mooresville Office (704) 660-3625 PERMIT # 205156

IMPROVEMENT PERMIT / AUTHORIZATION TO CONSTRUCT / OPERATION PERMIT / EXISTING SYSTEM

PIN # 4725971109

APPLICANT: Fawn Combs APPLICANT ADDRESS: 124 Fairmeter St.

SITE ADDRESS: 119 Classic Ln. PHONE: 704-880-2555 ALT. PHONE: N/A


SITE DIRECTIONS: Hwy 115 N TL Old Wilkesboro TL Classic Ln.

SUBDIVISION: Long Pine Heights SECTION: N/A LOT # 19+PT20 LOT AREA: 0.78 acres DESIGN FLOW: 240 gpd L.T.A.R.: 0.3

Septic Tank	1000	(gal)	STB	IM-1066	Date	Plastic Infi	☐ New System	☑ Repair	☐ Expansion	System Type: I II (III) IV V VI	☑ Residence	No. Bedrooms	2	Water Supply	
Pump Tank		(gal)	PT		Date		System Description:				☐ Business	No. Persons	4	☐ Private	
Pump Make		Model			Serial #		Repair System Description:	25% Reduction			☐ Other	No. Employees		☑ Public	
# Nitrification Fields	1	# Lines	4		Linear Ft:	168	Maintenance Agreement Required:	☐ YES	☑ NO		☐ Slab	☑ Crawl Space		☐ Community	
Trench Width	36"	Max. Trench Bottom Depth	36"		Gravel Depth	N/A		☑ GRAVITY	☐ PRESSURE		☐ Basement w/ plumbing			☐ Basement w/o plumbing	

Comments / Conditions: Install a 25% Reduction system with serial distribution. Pump & crush existing septic tank. Reroute plumbing & set new septic tank at location shown below. Install trenches a minimum of 3' on centers. ★

INITIAL SITE SKETCH

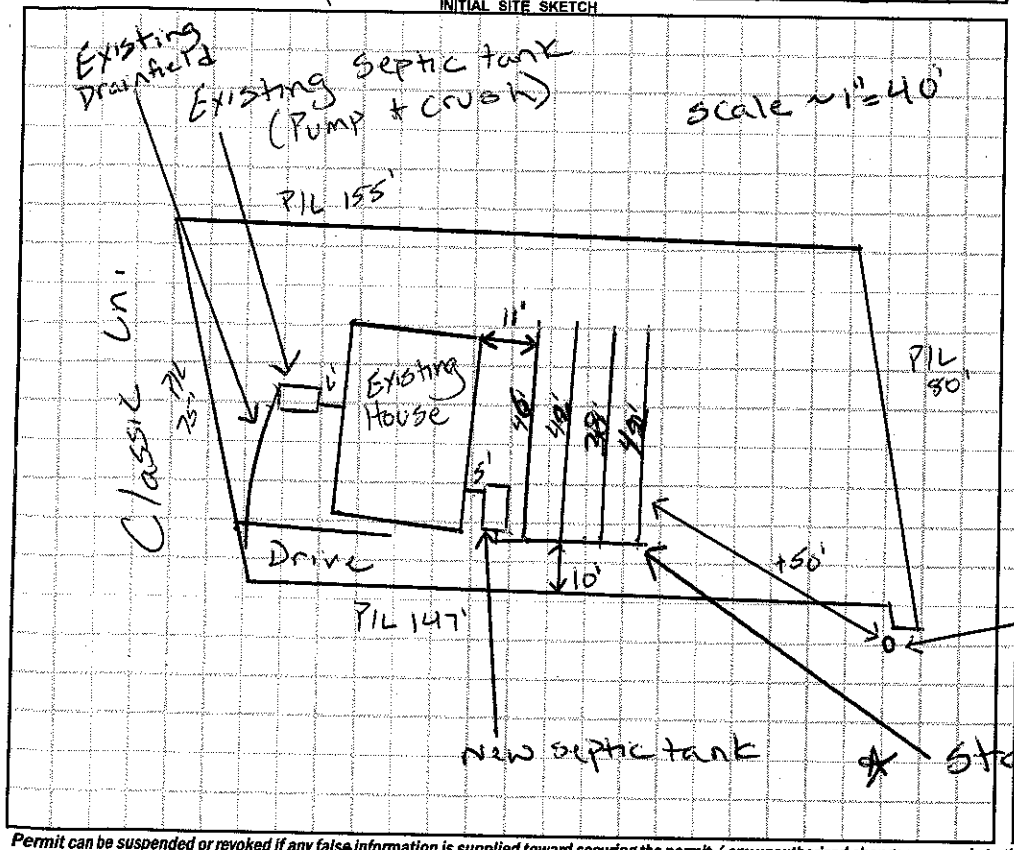

AS BUILT SKETCH

- Red Polyloc 6" lines installed
- Infiltrator Black Plastic S.T. Installed
- Quick 4 Chambers installed
- 168 total feet installed
- Installed as drawn

Permit can be suspended or revoked if any false information is supplied toward securing the permit / any unauthorized changes are made to the site / any unauthorized changes are made in the installation of the system. **CONTACT A LOCATOR SERVICE PRIOR TO ANY EXCAVATION**

☐ **IMPROVEMENT PERMIT** *with plat valid without expiration.* ☐ **IMPROVEMENT PERMIT** *with site plan valid for 60 mos.* ☑ **AUTHORIZATION TO CONSTRUCT** *valid for period equal to IMPROVEMENT PERMIT--not to exceed 60 mo.*

Owner / Applicant Signature: Fawn Combs Date: 8-26-14 Installed by: K+M Grading

IMPROVEMENT PERMIT by: Justa Henderson Date: 8-28-14 OPERATION PERMIT by: Justa Henderson Date: 10-9-14

AUTHORIZATION TO CONSTRUCT by: Justa Henderson Date: 8-28-14 Existing System Inspected by: Date:

Health Dept. Copy - WHITE Applicant (Final Approval) - YELLOW Applicant (Conditional Approval) - PINK