IREDELL COUNTY HEALTH DEPARTMENT

Mooresville Phone TR 3-7271 Mooresville Phone No. 664-5281

PERMIT TO INSTALL SEPTIC TANK

Permit No. ____ Permit Date 9-4 1973

Owner R.E. Foy Address Statesville, NC

Installed By Robert Hoke & R.E. Foy Address Statesville, N.C.


Location of Property NORTHMONT
Lot. # 43

Tank		Capacity		Length of Lines		Fixtures	
Block	( )	1000	( )	225'	( )	No. of Baths	(2)
Precast	(✓)	1250	(✓)	250'	( )	Dishwasher	(✓)
		1500	( )	Other 255'		Garbage Grdr.	(✓)
		Other ____				Other ____	

NOTIFY HEALTH DEPARTMENT AT LEAST EIGHT HOURS BEFORE TANK IS TO BE INSPECTED.

Final Inspection 9-6 1973 Approved (✓) Disapproved ( )

Remarks Community Water Supply

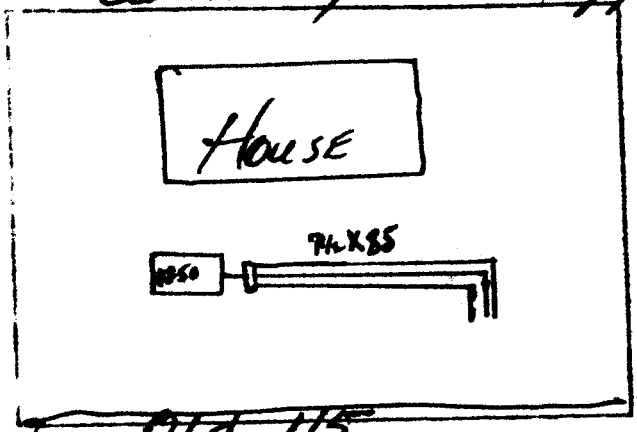

Old of Ills
Sketch of Installation

Sanitarian