ICHD - ENVIRONMENTAL HEALTH DIVISION

Statesville Office (704) 878-5305 x3456 Mooresville Office (704) 660-3625

SEPTIC: IMPROVEMENT PERMIT / AUTHORIZATION TO CONSTRUCT / OPERATION PERMIT / EXISTING SYSTEM

PERMIT : OSWP - 2024-52238

~~PIN #~~ 4725 -- 97 -- 4926

APPLICANT/OWNER: ALLEN BUMGARNER

APPLICANT ADDRESS: 127 HEAVENLY DRIVE, STATESVILLE, N.C. 28625

SITE ADDRESS: 127 HEAVENLY DRIVE, STATESVILLE, N.C. 28625

PHONE: 704-928-5436

ALT. PHONE --

SITE DIRECTIONS: (N) ON 115, (L) ON OLD WILKESBORO, (R) ON CREEKSIDE, (R) ON HEAVENLY, LOT ON (R)

SAP CONTROLLED: ☐ ~~YES~~ ☐ ~~NO~~ EXT

SUBDIVISION: NORTHMONT

SECTION: 1

LOT # 32 + 71

LOT AREA: 1.05 AC

DESIGN FLOW: EXT

L.T.A.R.(Initial): EXT

L.T.A.R (Repair): EXT

Septic Tank	1000 (gal)	STB	~~Mod~~	Date		☐ New System	☑ Repair	☐ Expansion	System Type: I (II) III IV V VI
Pump Tank	-- (gal)	PT	--	Date	--	System Description:	EXISTING - CONVENTIONAL		
Pump Make	--	Model	--	Serial #	--	Repair System Description:	TANK REPLACEMENT		
# Nitrification Fields	EXT	# Lines	EXT	Linear Ft	EXT	Maintenance Agreement Required:	☐ YES	☑ NO	
Trench Width	EXT	*Max. Trench Depth(Initial)	EXT	*Max. Trench Depth(Repair)	EXT	Gravel Depth	EXT	☑ GRAVITY	☐ PRESSURE

* Measured on the downhill side of the trench

Effluent Standard: ☑ DSE ☐ HSE ☐ TS-I ☐ TS-II ☐ RCW ☐ NSF/ANSI 40

Usable Depth to LC (Initial): EXT

Usable Depth to LC (Repair): EXT

☑ Residence ☐ Business ☐ Other ☐ Slab ☐ Basement w/plumbing

No. Bedrooms 3 | No. Persons 6 | No. Employees -- | ☐ Crawl Space | ☐ Basement w/o plumbing

Water Supply: ☐ Private ☑ Public ☐ Community


Limiting Condition

Comments / Conditions: PUMP, CRUSH AND FILL EXISTING SEPTIC TANK, INSPECT AND REPLACE DISTRIBUTION DEVICES AS NEEDED, DO NOT EXCEED 36 IN OF COVER OVER NEW TANK

SYSTEM APPEARED TO BE FUNCTIONING AT TIME of INSPECTION

SEE NEW PLAT IN DEED BOOK 3060 PAGES 424-426

INITIAL SITE SKETCH

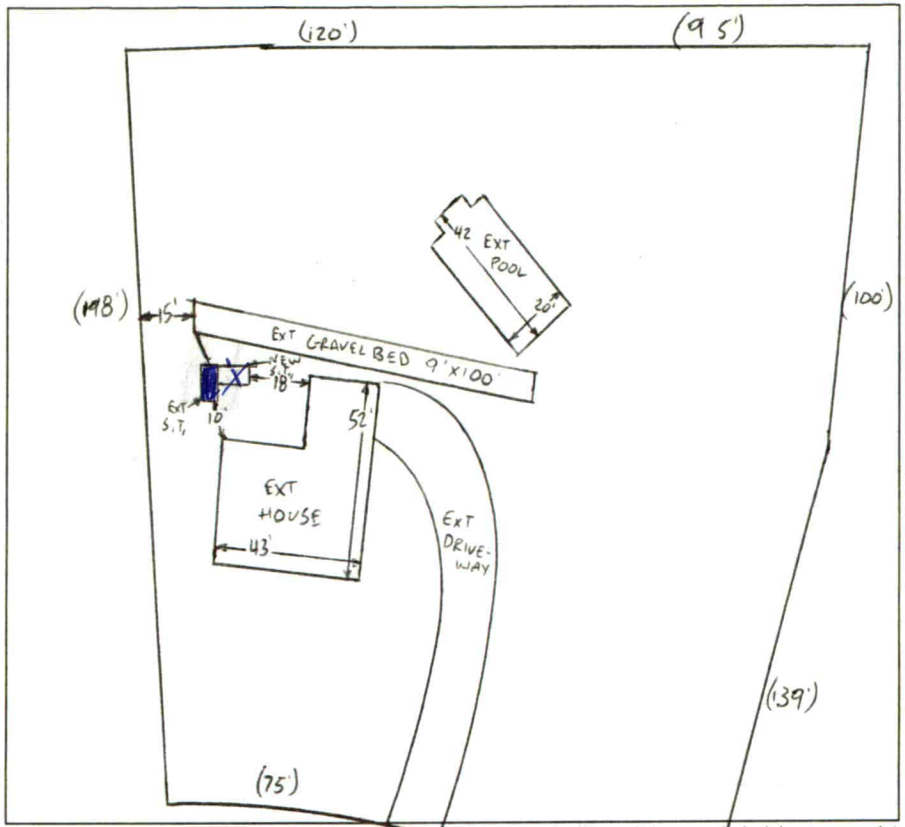

AS BUILT SKETCH

FOR SEPTIC FINAL INSPECTION CALL: 704-664-3703 between 8am-9am

the day the inspection is needed. Be sure to speak with an inspector to confirm your time.

1 IN = 50 FT

S.T. = SEPTIC TANK

EXT = EXISTING

New tank in blue

Permit can be suspended or revoked if any false information is supplied toward securing the permit / any unauthorized changes are made to the site / any unauthorized changes are made in the installation of the system. **CONTACT A LOCATOR SERVICE PRIOR TO ANY EXCAVATION**

☐ **IMPROVEMENT PERMIT** *with plat* valid without expiration. ☐ **IMPROVEMENT PERMIT** *with site plan* valid for 60 mos. ☑ ~~AUTHORIZATION TO CONSTRUCT~~ valid for period equal to IMPROVEMENT PERMIT--not to exceed 60 mo.

Owner / Applicant Signature: ONLINE SIGNATURE Date: --

Installed by: Lentz

IMPROVEMENT PERMIT by: Burnett C. White Date: 5-16-2024

OPERATION PERMIT by: D. Mebane Date: 5/24/24

AUTHORIZATION TO CONSTRUCT by: Burnett C. White Date: 5-16-2024

Existing System Inspected by: Date:

ICHD - ENVIRONMENTAL HEALTH DIVISION

Statesville Office (704) 878-5305 x3456 Mooresville Office (704) 660-3625 CW

PERMIT : OSWP - 2024-52238

SEPTIC: IMPROVEMENT PERMIT / AUTHORIZATION TO CONSTRUCT / OPERATION PERMIT / EXISTING SYSTEM

PIN # -- --

APPLICANT/OWNER: ALLEN BUMGARNER APPLICANT ADDRESS: 127 HEAVENLY DRIVE, STATESVILLE, N.C. 28625

SITE ADDRESS: 127 HEAVENLY DRIVE, STATESVILLE, N.C. 28625 PHONE: 704-928-5436 ALT. PHONE –

SITE DIRECTIONS: (N) ON 115, (L) ON OLD WILKESBORO, (R) ON CREEKSIDE, (R) ON HEAVENLY, LOT ON (P) SAP CONTROLLED: ☐ ~~YES~~ ☐ ~~NO~~ EXT

SUBDIVISION: NORTHMONT SECTION: – LOT # 32+71 LOT AREA: 1.05 AC DESIGN FLOW: EXT L.T.A.R.(Initial): EXT L.T.A.R (Repair): EXT


Septic Tank	1000	(gal)	STB		Date		☐ New System	☑ Repair	☐ Expansion	System Type: I (II) III IV V VI	☑ Residence	No. Bedrooms	3	Water Supply
Pump Tank	–	(gal)	PT	–	Date	–	System Description:	EXISTING - CONVENTIONAL			☐ Business	No. Persons	6	☐ Private
Pump Make	–		Model	–	Serial #	–	Repair System Description:	TANK REPLACEMENT			☐ Other	No. Employees	–	☑ Public
# Nitrification Fields	EXT	# Lines	EXT		Linear Ft	EXT	Maintenance Agreement Required:	☐ YES	☑ NO		☐ Slab	☐ Crawl Space		☐ Community
Trench Width	EXT	*Max. Trench Depth(Initial)	EXT	*Max. Trench Depth(Repair)	EXT	Gravel Depth	EXT	☑ GRAVITY	☐ PRESSURE		☐ Basement w/plumbing		☐ Basement w/o plumbing	

* Measured on the downhill side of the trench Effluent Standard: ☑ DSE ☐ HSE ☐ TS-I ☐ TS-II ☐ RCW ☐ NSF/ANSI 40 Usable Depth to LC (Initial): EXT Usable Depth to LC (Repair): EXT *Limiting Condition*

Comments / Conditions: PUMP, CRUSH AND FILL EXISTING SEPTIC TANK, INSPECT AND REPLACE DISTRIBUTION DEVICES AS NEEDED, DO NOT EXCEED 36 IN OF COVER OVER NEW TANK

SYSTEM APPEARED TO BE FUNCTIONING AT TIME OF INSPECTION
SEE NEW PLAT IN DEED BOOK 3060 PAGES 424-426

INITIAL SITE SKETCH

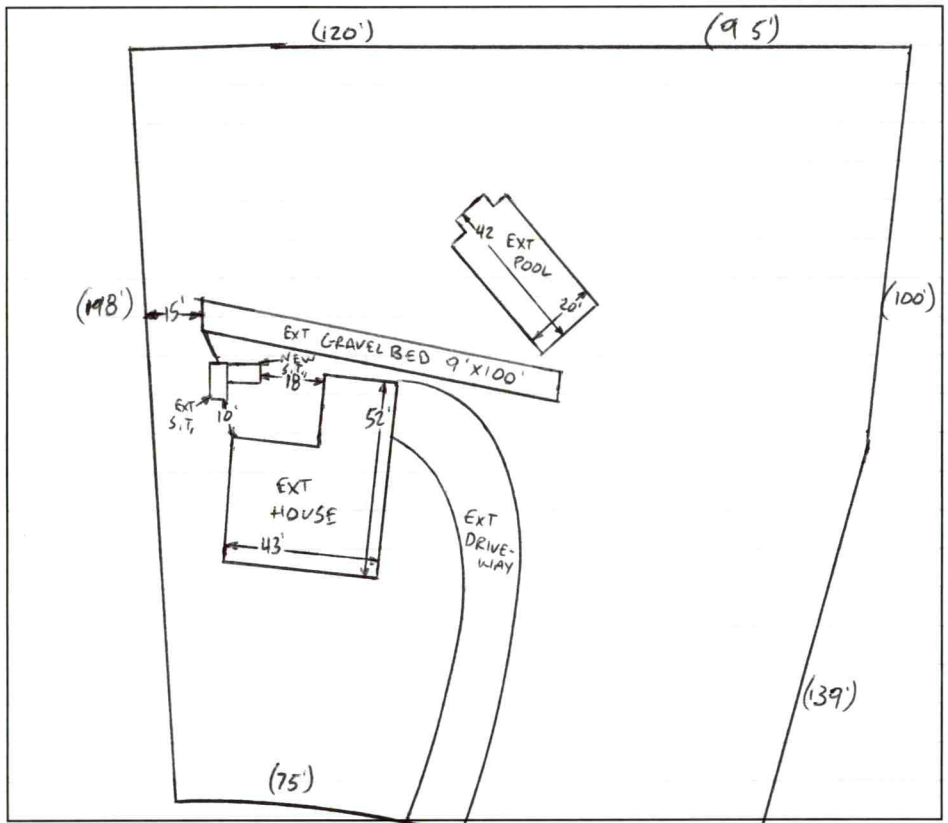

AS BUILT SKETCH

FOR SEPTIC FINAL INSPECTION CALL: 704-664-3703 between 8am-9am
the day the inspection is needed. Be sure to speak with an inspector to confirm your time.

1 IN = 50FT
S.T. = SEPTIC TANK
EXT = EXISTING

Permit can be suspended or revoked if any false information is supplied toward securing the permit / any unauthorized changes are made to the site / any unauthorized changes are made in the installation of the system. **CONTACT A LOCATOR SERVICE PRIOR TO ANY EXCAVATION**

☐ **IMPROVEMENT PERMIT** *with plat valid without expiration.* ☐ **IMPROVEMENT PERMIT** *with site plan valid for 60 mos.* ☑ ~~**AUTHORIZATION TO CONSTRUCT**~~ *valid for period equal to IMPROVEMENT PERMIT--not to exceed 60 mo.*

Owner / Applicant Signature: ONLINE SIGNATURE Date: – Installed by:

IMPROVEMENT PERMIT by: Burnett C. White Date: 5-16-2024 OPERATION PERMIT by: Date:

AUTHORIZATION TO CONSTRUCT by: Burnett C. White Date: 5-16-2024 Existing System Inspected by: Date:

Item	Date	Initials
Drain Lines Checked		
Tanks Checked		
Pressure Manifold or Valve Box Checked		
Pressure Head Set		
Electrical Checked		
Floats Set		
Alarm Checked		
Maintenance Contract Needed? Y / N		
Comments:		

Repairs Only	
	State Code
Failing System Code	
Type of Distribution	G or P
Type of Failure/Malfunction	
Primary Cause of Failure/Malfunction	
Age of System? _____	
Initial or Repair? _____	


4725-98-5
95
199
300
34
223
4725-98-3135
4725-98-4148
4725-98-2170
230
149
4725-98-60
95
100
43
32
4725-97-6
55
31
80
4725-98-2003
120
4725-97-4967
4725-97-5957
203
139
4725-97-3992
4725-97-1947
145
6
21
St outlet
82
127
72
127
Inlet
4725-97-0970
4725-97-3825
75
4725-97-6
123
68
Heavenly Dr
73
4725-97-2766
290
4725-97-5737
124
55
122
150
4725-97-0628
74
70
4725-97-3607
56
4725-97-6616
1 in = 50 ft

PERMIT SNAPSHOT REPORT OSWP-2024-52238
FOR IREDELL COUNTY

Permit Type:	Environmental Health OSWP	**Project:**		**App Date:**	04/26/2024
Work Class:	EH Septic Permit	**District:**	Iredell County	**Exp Date:**	NOT AVAILABLE
Status:	PRIORITY PERMIT	**Square Feet:**	0.00	**Completed:**	NOT COMPLETED
Valuation:	$0.00	**Assigned To:**	White, Bryant	**Approval Expire Date:**	

Description: The septic tank is cracked. The septic tank is uncovered and cracks are visible.

Parcel: 4725973992.000 Main	**Address:** 127 Heavenly Dr Statesville, NC 28625 Main	**Zone:** RA(Residential Agricultural District)

Applicant/Authorized Agent
Jeanie Lentz
463 Lentz Road
Statesville, NC 28625


Property Owner
Allen Bumgarner
Home: (704) 928-5436

Permit Custom Fields

How is your site plan being submitted	Custom Site Plan	Septic Application/Permit Type	Repair	Does the site contain any jurisdictional wetlands	No
Non-domestic Sewage Generated	No	Other Public Agency	No	All proposed structure dimensions	N/A
What are the proposed structures	Other Addition/Structure	Maximum Number of Bedrooms	3	If other Addition/Structure, please explain	
Number of Occupants	2	Foundation Type	Basement with Plumbing	Water Supply	Existing Well
Desired Septic System Type	Conventional (most common)	Additional Unique Setbacks Apply	No		

Attachment File Name	Added On	Added By	Attachment Group	Notes
Signature_Jeanie_Lentz_4/26/2024.jpg	04/26/2024 15:21	Lentz, Jeanie		Uploaded via CSS
127_Heavenly_Drive_-_Authorize_Legal_Representative-walkingbum37_gmail.com_v1.pdf	04/29/2024 10:48	Lentz, Jeanie	Available Online	

Workflow Step / Action Name	Action Type	Start Date	End Date
Application Completeness Check v.1		04/29/2024 10:48	04/29/2024 10:49
Confirm application complete v.1	Generic Action		04/29/2024 10:49
~~**Zoning Review v.1**~~			04/29/2024 10:48
~~Floodplain Admin Overview v.1~~	Task		04/29/2024 10:48
~~Issue Invoice v.1~~	Generic Action		04/29/2024 10:48
~~Fees Paid v.1~~	Generic Action		04/29/2024 10:48
Fees v.1			
Issue Invoice v.1	Generic Action		
Fees Paid v.1	Generic Action		
Lot Readiness Verification v.1			
OSWP Septic Preliminary Site Visit v.1	Inspection		
OSWP Site Evaluation v.1	Inspection		
Issue Improvement Permit v.1			
Issue Invoice v.1	Generic Action		
Fees Paid v.1	Generic Action		
Issue Permit v.1	Generic Action		
Permit Completion Process v.1			
Authorization to Construct Permit v.1	Create Sub Permit		
Issue Authorization to Construct v.1	Generic Action		

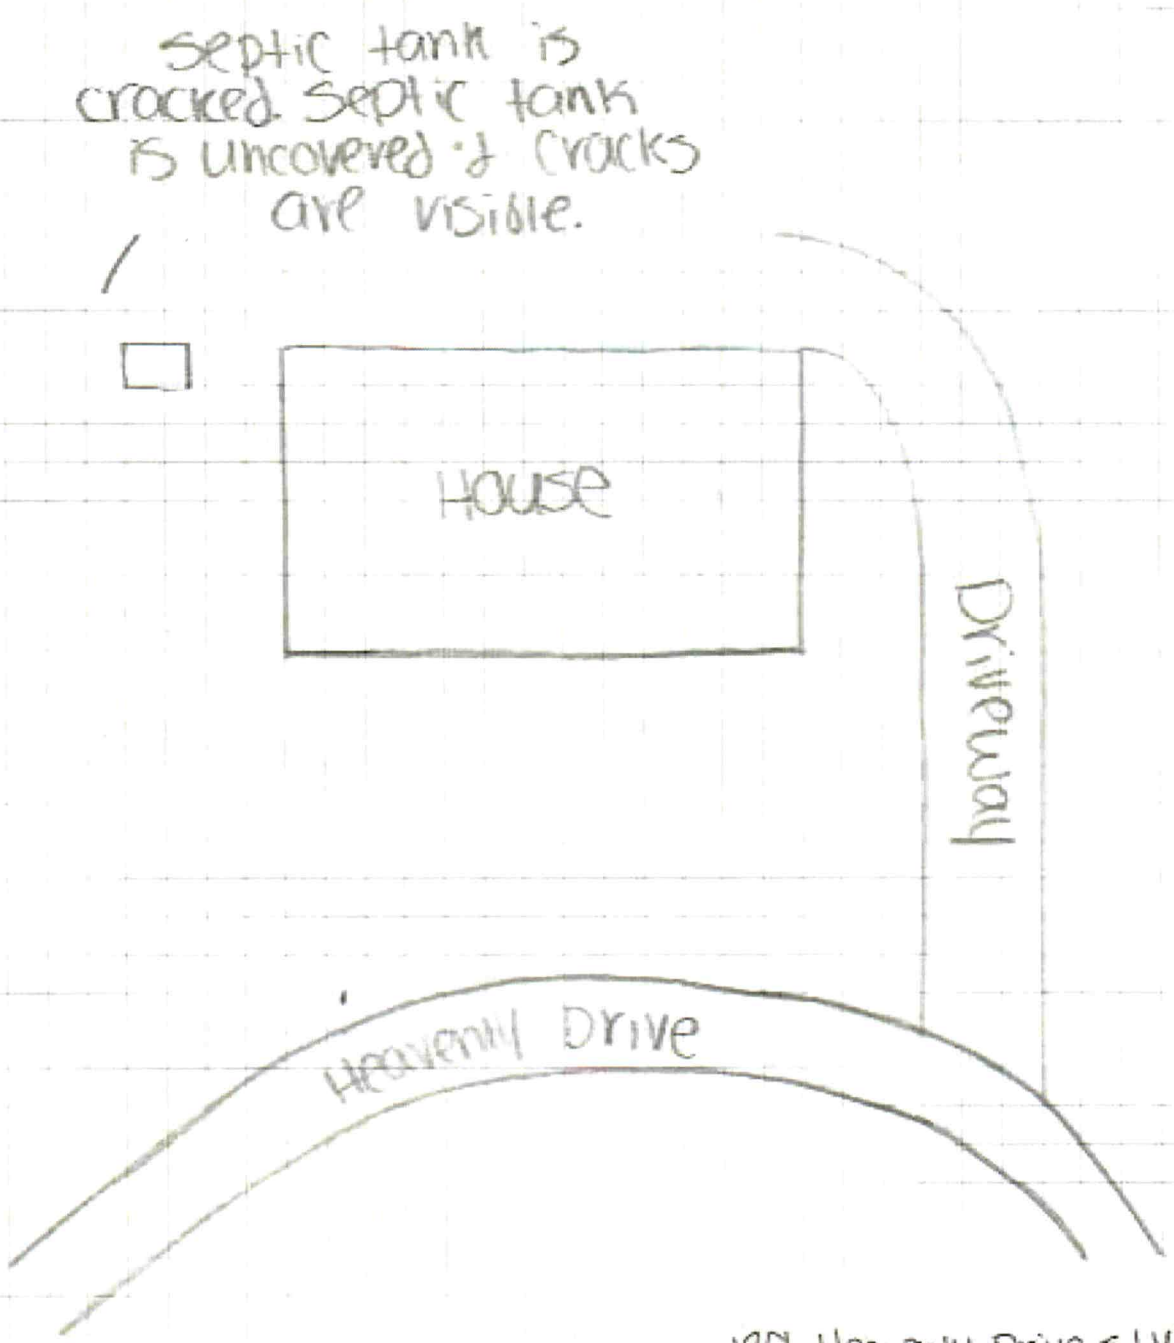

Address: 129 Heavenly Drive STVL
Current HO: Allen Bumgarner
HO #: 704-928-5430
# of Bed: 3 **# of Occupants:** 1
Foundation Type: Crawlspace Slab (B/WP) B/WOP
Water supply: (Public) Well **Other:** _____