* Repair

IREDELL COUNTY HEALTH DEPARTMENT

STATESVILLE 704-878-5305 MOORESVILLE 704-664-5281

IMPROVEMENT PERMIT / AUTHORIZATION TO CONSTRUCT / OPERATION PERMIT / EXISTING SYSTEM INSPECTION

PERMIT # Repair PIN # 4725-97-5481 DATE 15 May 09

OWNER or APPLICANT Christopher Scott Devine PHONE: Business Home: (704) 402-9134

OWNER or APPLICANT ADDRESS 105 Heavenly Drive Statesville

LOCATION / DIRECTIONS Old Millersburg Rd. Turn onto Northmont - 2nd on Left. Intersection of Heavenly Dr.

SUBDIVISION Northmont BLOCK / SECTION 11 LOT # 45 LOT AREA DESIGN FLOW 360 gpd L.T.A.R. 0.3/A/D

Septic Tank Exist. Gallons: STB Date

Pump Tank 1000 Gallons: P T Date

Pump Make Model Serial #

Nitrification Field No Fields 1 No Lines 6 Linear Feet 200

Trench Width 24" Max. Trench Bottom Depth 36" Gravel Depth NA

☐ New System ☑ Repair ☐ Expansion System Type I II III IV V VI

System Description: 50% Reduction - Pressure Manifold

Repair System Description:

Maintenance Agreement Required ☐ YES ☑ NO

☐ GRAVITY ☑ PRESSURE

☑ Residence No. Bedrooms 3

☐ Business No. Persons

☐ Other No. Employees

☐ Slab ☐ Crawl Space


☑ Basement w/plumbing ☐ Basement w/o plumbing

Water Supply: ☐ Private ☑ Public ☐ Community

Comments / Conditions: Install TBJ Panel in 6 lines / Keep nitrification trenches 8' from basement / Keep out of road r/w

Comments / Conditions: * Repair any leaking plumbing and replace plumbing with low-flow fixtures where possible

INITIAL SITE SKETCH

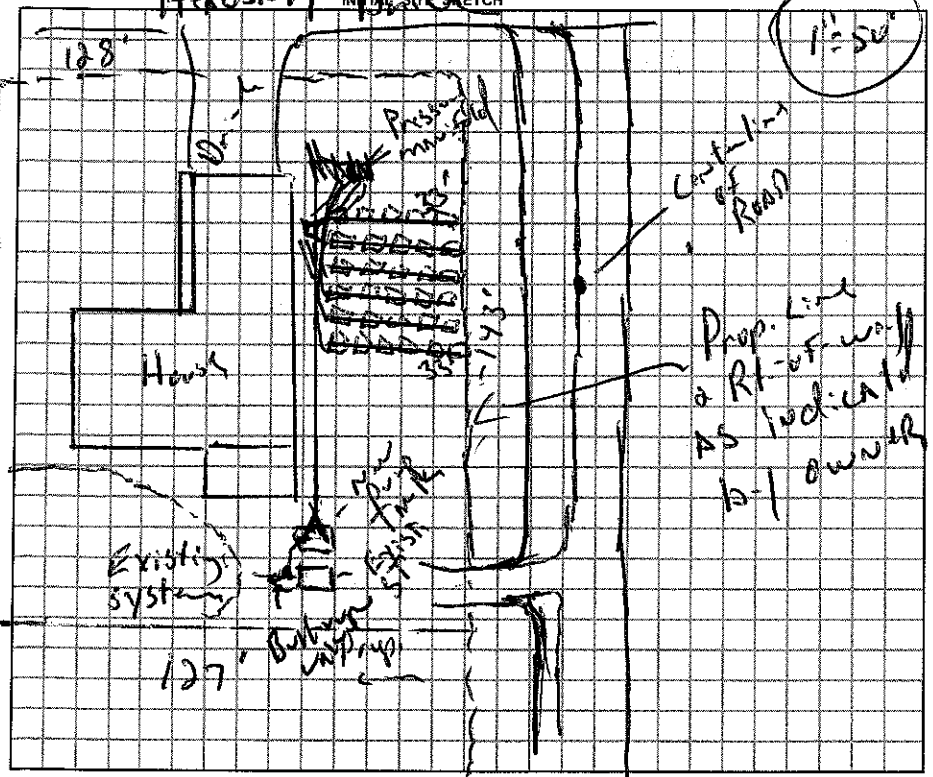

AS BUILT SKETCH

Installed as Drawn.

Permit can be suspended or revoked if any false information is supplied toward securing the permit / any unauthorized changes are made to the site / any unauthorized changes are made in the installation of the system.

☐ IMPROVEMENT PERMIT w / plan valid without expiration. ☐ IMPROVEMENT PERMIT w / site plan valid for 60 mos. ☑ AUTHORIZATION TO CONSTRUCT valid for period equal to IMPROVEMENT PERMIT-not to exceed 60 mo.

Owner / Applicant Signature: Date 15 May 09

Improvement Permit by: Date

Authorization to Construct by: R.S. Date 15 May 09

Installed by: Young's Grading

Operation Permit by: R.S. Date: 4 June 09

Existing System Inspected by: Date:

YOU SHOULD CONTACT A LOCATOR SERVICE PRIOR TO ANY EXCAVATION.

WHITE COPY Environmental Health YELLOW COPY (Final) Owner / Applicant PINK COPY (Initial) Owner / Applicant