IREDELL COUNTY HEALTH DEPARTMENT

Statesville Phone TR 3-7271 Mooresville Phone No. 664-5281

PERMIT TO INSTALL SEPTIC TANK

Permit No. 511 Permit Date 7-13 1923

Owner Bldr. R.E. Foy Address Statesville.

Installed By Robert Hoke + R.E. Foy Address Statesville,


Location of Property Northmont — Lot # 45

Tank		Capacity		Length of Lines		Fixtures	
Block	( )	1000	( )	225'	( )	No. of Baths	(3)
Precast	(✓)	1250	(✓)	250'	( )	Dishwasher	(✓)
		1500	( )	Other 270		Garbage Grdr.	(✓)
		Other				Other	

NOTIFY HEALTH DEPARTMENT AT LEAST EIGHT HOURS BEFORE TANK IS TO BE INSPECTED.

Final Inspection 7-13 1923 Approved (✓) Disapproved ( )

Remarks Community Water Supply

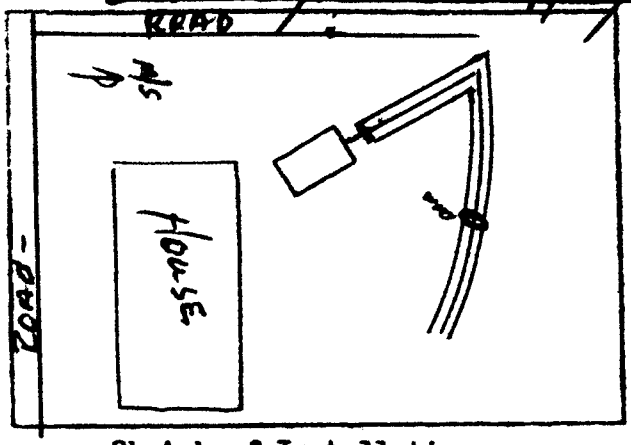

Sketch of Installation

Sanitarian