IREDELL COUNTY HEALTH DEPARTMENT

(SEPTIC TANK) IMPROVEMENTS PERMIT AND CERTIFICATE OF COMPLETION
(Ground Absorption Sewage Disposal System – G. S. Chapter 130-Article 13C)

OWNER OR CONTRACTOR Ben Daniels DATE 9-20-77 PERMIT NO. _____

PHONE: Business _____ Home _____

LOCATION 115N T.L. on S.R. 1645 (Old Wilkesboro Rd.) x creek on Rt. S. R. No. _____

SUBDIVISION NAME Northmont LOT NO. 91 SECTION OR BLOCK NO. _____


House (✓) Mobile Home ( ) Business ( ) Other _____

No. Bedrooms 3 No. Bathrooms 2

Garbage Disposal Unit	Yes	(✓)	No	( )	
Auto. Dishwasher	Yes	(✓)	No	( )	
Auto. Wash. Machine	Yes	(✓)	No	( )	
Site Suitable	Yes	(✓)	No	( )	

Lot Area 2/ac

Character & Porosity of Soil Terrace soil mixed w/ some cecil
Percolation Rate —
Topography 2%
Depth to Water Table 5-6'+
Rock or other impervious formations none obs.

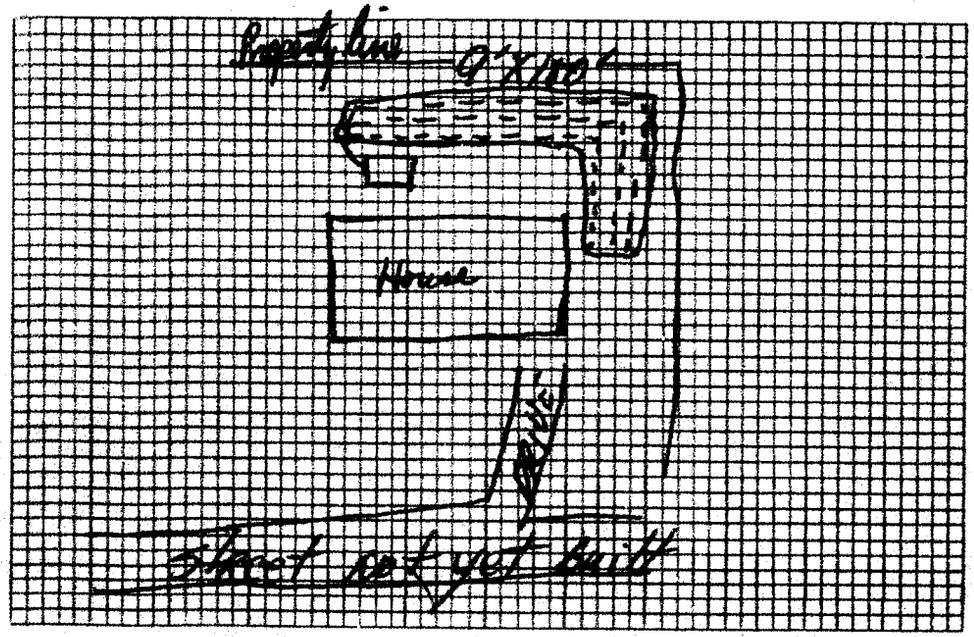

Plot of System

Size of Tank 1500 Gals.
Nitrification Field:
No. of Lines 3
Sq. Ft. 900 Linear Ft. 300
Depth of Stone in Lines 16"+
Water Supply: Individual ( )
Public (✓)

Installed by James Shore

IMPROVEMENTS PERMIT BY Hamil R. Hinson

COMMENTS: System installed before house was built due to questions about water table level and to keep system from being too deep

CERTIFICATE OF COMPLETION BY Hamil R. Hinson DATE 9-30-77

CONSTRUCTION MUST COMPLY WITH ALL OTHER APPLICABLE STATE AND LOCAL REGULATIONS.

Health Dept. Copy: White Inspection Dept. Copy: Yellow Sanitarian's Copy: Pink Owner's Copy: Gold