IREDELL COUNTY HEALTH DEPARTMENT

STATESVILLE 704-878-5305 MOORESVILLE 704-664-5281

IMPROVEMENT PERMIT / AUTHORIZATION TO CONSTRUCT / OPERATION PERMIT / EXISTING SYSTEM INSPECTION

PERMIT# 126319 PIN# 4726-02-3576 DATE 3-25-05

OWNER OR CONTRACTOR TBJ PROPERTIES, LLC PHONE: Business 704-902-4618 Home 704-876-1984

ADDRESS 413 MILLER FARM ROAD, STATESVILLE, NC 28625

LOCATION NC 115 NORTH, TL SCOTTS CREEK RD, TL CELTIC RIDGE DR, TR NATHANIEL GRACE DR, 2ND LOT ON RIGHT

SUBDIVISION CELTIC RIDGE BLOCK / SECTION ____ LOT 23 LOT AREA 0.459 ACRE SITE CLASS. PS DESIGN FLOW 360 L.T.A.R. 0.30 GPD/FT²

Septic Tank: 1000 Gallons; STB 1012 Date 3-17-05
Pump Tank: ____ Gallons; PT ____ Date ____
Pump Make: ____ Model ____ Serial No. ____
Nitrification Field: No Fields 1 Square Feet 1200 Linear Feet 300
No Lines FOUR Trench Width 36" Max Trench Bottom Depth 36" Gravel Depth N/A

☑ New System ☐ Repair System Type: I, II, III, IV, V, VI
System Description: 25% REDUCTION, GRAVITY
Repair System Description: 50% REDUCTION, LAY
Maintenance Agreement Required: ☐ Yes ☑ No PRESSURE ☐ Other ____


☑ House/Mod. Home ☐ Mobile Home ☐ Business
No. Bedrooms 3 No. Bathrooms ____ No. Employees ____
☐ Slab ☑ Crawl Space ☐ Basement w/plumbing ☐ Basement wo/plumbing

Water Supply: ☐ Individual ☑ Public ☐ Community


Comments:/Conditions: INSTALL 25% REDUCTION SYSTEM ON CONTOUR

Comments:/Conditions: Yellow tag - Tele Parker
Septic Tank Inside

INITIAL SITE SKETCH

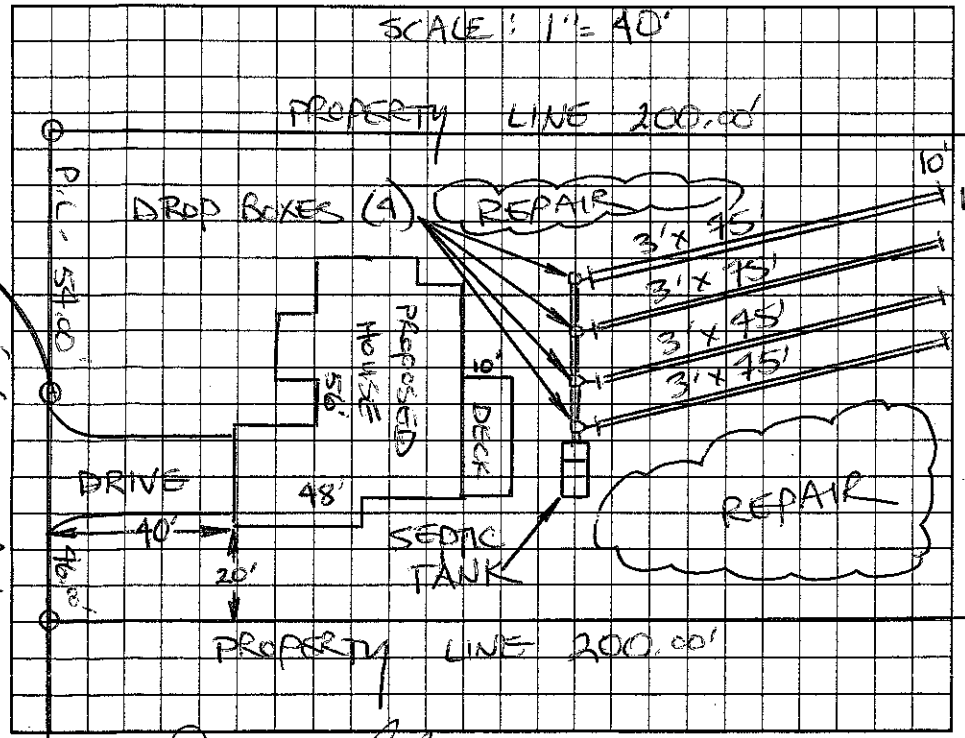

AS BUILT SKETCH

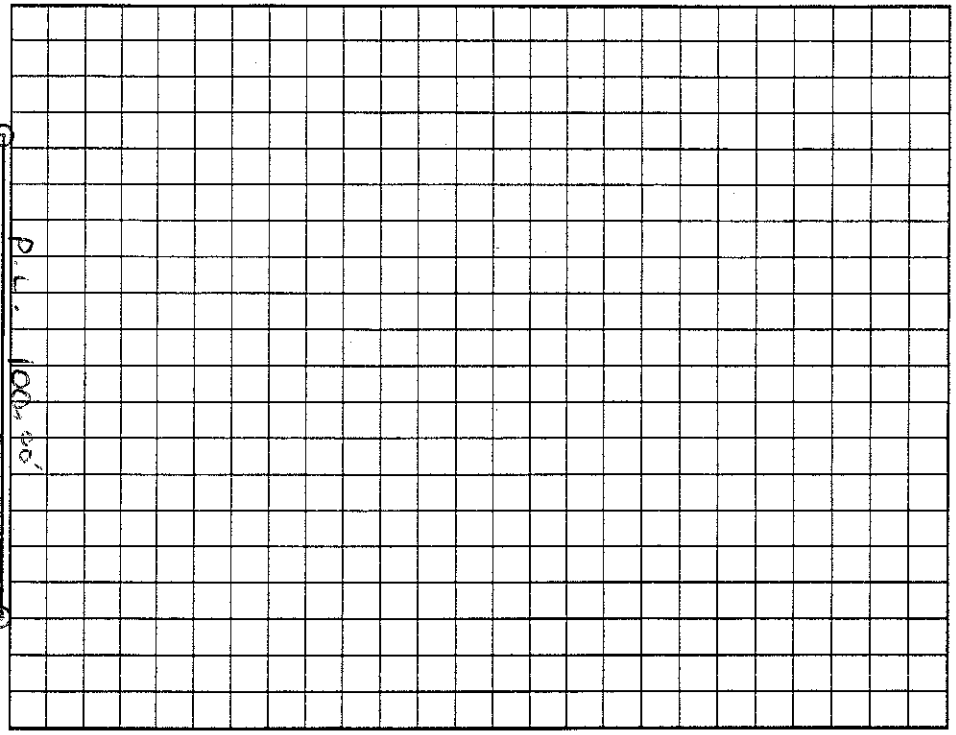

LOT 23 .459 AC NATHANIEL GRACE DRIVE

Permit can be suspended or revoked if any false information is supplied toward securing the permit/any unauthorized changes are made to the site/any unauthorized changes are made in the installation of the system. Improvement Permit with plat valid without expiration. Improvement Permit with site plan valid for sixty months. Authorization to Construct is valid for a period equal to that of Improvement Permit – not to exceed sixty months.

Signed: [signature] date 3-23-05 Installed by: Steve Jordan

Improvement Permit by: STEVE HEDRICK date 3-23-05 Operation Permit by: [signature] date 8-14-06

Authorization to Construct by: STEVE HEDRICK date 3-23-05 Existing System Inspection by: ____ date ____

HEALTH DEPT. COPY: WHITE OWNER COPY (FINAL): YELLOW OWNER COPY (INITIAL): PINK