IREDELL COUNTY HEALTH DEPARTMENT

STATESVILLE 704-878-5305 CJ MOORESVILLE 704-664-5281

IMPROVEMENT PERMIT / AUTHORIZATION TO CONSTRUCT / OPERATION PERMIT / EXISTING SYSTEM INSPECTION

PERMIT# 112830 PIN# 4726-02-5705 DATE 6/12/03

OWNER OR CONTRACTOR Marty Maltby PHONE: Business (704) 902-3907 Home —

ADDRESS 3624 Gordon Street, Terrell, NC 28682

LOCATION Hwy 115 N (L) Scotts Creek Rd, (L) Celtic Ridge Dr (R) Dundee, Corner lot on Left

SUBDIVISION Celtic Ridge BLOCK / SECTION — LOT 25 LOT AREA — SITE CLASS. PS DESIGN FLOW 360 L.T.A.R. .25

Septic Tank: 1000 Gallons; STB 1012 Date 2-25-03

Pump Tank: — Gallons; PT — Date —

Pump Make: — Model — Serial No. —

Nitrification Field: No Fields 1 Square Feet 1440 Linear Feet 360

No Lines Four (4) Trench Width 36" Max Trench Bottom Depth 30" Gravel Depth NA

☒ New System ☐ Repair System Type: I, II, (III) IV, V, VI

System Description: Gravity, 25% Reduction

Repair System Description: Gravity, Pump, 50% Reduction

Maintenance Agreement Required: ☐ Yes ☐ No

☒ House/Mod. Home ☐ Mobile Home ☐ Business ☐ Other

No. Bedrooms 3 No. Bathrooms 2 No. Employees —


☐ Slab ☒ Crawl Space ☐ Basement w/plumbing ☐ Basement wo/plumbing

Water Supply: ☐ Individual ☒ Public ☐ Community


Comments:/Conditions: (1) Install lines on contour (2) Maintain proper Setbacks

Comments:/Conditions:
- Tuff-Tite Fitter + ST. Marker Installed
- 58 Infiltrators Chambers Installed

INITIAL SITE SKETCH 1" = 40'

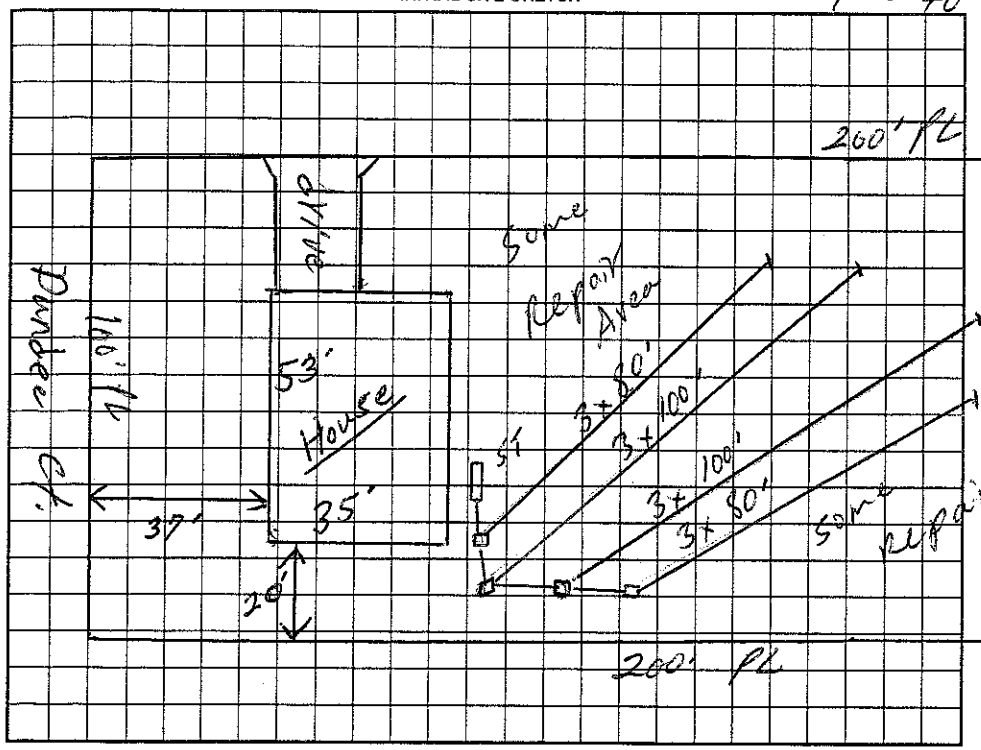

AS BUILT SKETCH 1" = 50'

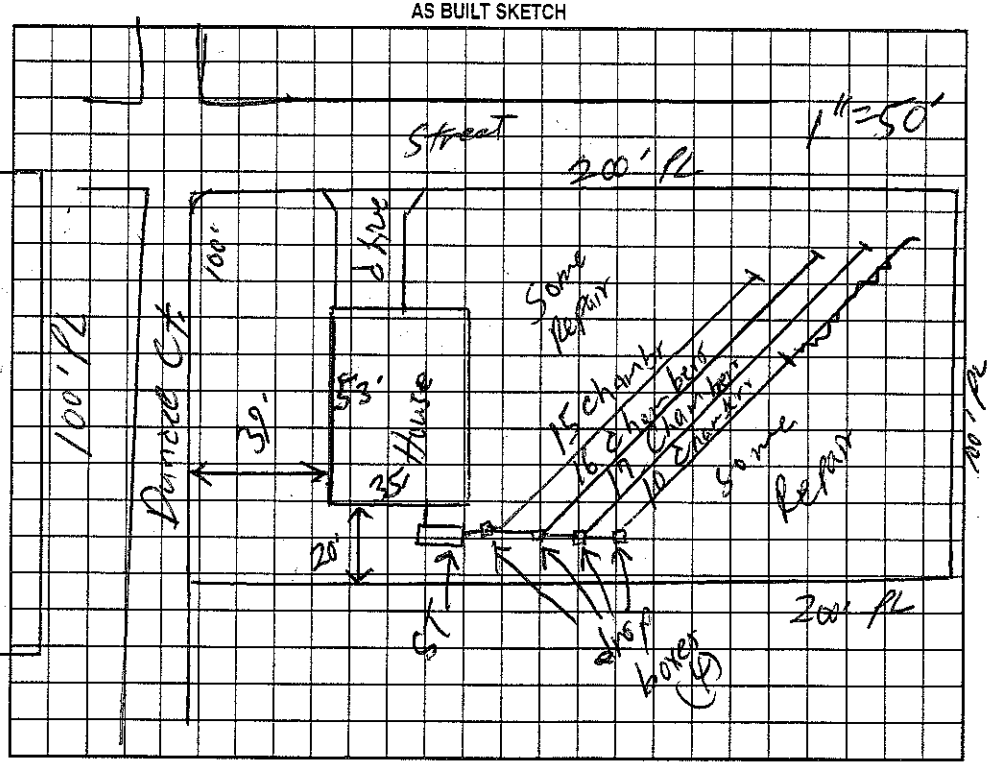

Permit can be suspended or revoked if any false information is supplied toward securing the permit/any unauthorized changes are made to the site/any unauthorized changes are made in the installation of the system. Improvement Permit with plat valid without expiration. Improvement Permit with site plan valid for sixty months. Authorization to Construct is valid for a period equal to that of Improvement Permit – not to exceed sixty months.

Signed: Jeffrey Ward date 6-13-03

Improvement Permit by: William O. Johnson date 6/12/03

Authorization to Construct by: William O. Johnson date 6/12/03

Installed by: Tommy Frye

Operation Permit by: William O. Johnson date 9-2-03

Existing System Inspection by: — date —

HEALTH DEPT. COPY: WHITE OWNER COPY (FINAL): YELLOW OWNER COPY (INITIAL): PINK