IREDELL COUNTY HEALTH DEPARTMENT

STATESVILLE 704-878-5305 MOORESVILLE 704-664-5281

IMPROVEMENT PERMIT / AUTHORIZATION TO CONSTRUCT / OPERATION PERMIT / EXISTING SYSTEM INSPECTION

PERMIT# 112320 PIN# 4726-02-6279 DATE 1/7/04

OWNER OR CONTRACTOR General Contract Services Inc. PHONE: Business — Home (704)622-3544

ADDRESS P.O. Box 4253 Mooresville, N.C. 28117

LOCATION Hwy 115 N (L) Scotts Creek Rd. (L) Celtic Ridge (L) Nathanael Grace, 2nd lot on Right

SUBDIVISION Celtic Ridge BLOCK / SECTION — LOT 20 LOT AREA .478 Ac. SITE CLASS. P5 DESIGN FLOW 360 L.T.A.R. .25 .24/.72

Septic Tank: 4000 Gallons; STB 825 Date 3-29-04
Pump Tank: — Gallons; PT — Date —
Pump Make: — Model — Serial No. —
Nitrification Field: No Fields 1 Square Feet 1440 Linear Feet 360
No Lines 5 Trench Width 36" Max Trench Bottom Depth 36" Gravel Depth N/A

☒ New System ☐ Repair System Type: I, II, (III), IV, V, VI
System Description: Gravity 25% Reduction
Repair System Description: Pump, LP Panel
Maintenance Agreement Required: ☐ Yes ☒ No

☒ House/Mod. Home ☐ Mobile Home ☐ Business ☐ Other
No. Bedrooms 3 No. Bathrooms — No. Employees —


☒ Slab ☐ Crawl Space ☐ Basement w/plumbing ☐ Basement wo/plumbing

Water Supply: ☐ Individual ☒ Public ☐ Community


Comments:/Conditions: (1) Stub out should be at elevation to ensure maximum 36" trench bottom depth is not exceeded. If this condition cannot be met permit will be voided.

Comments:/Conditions: -56 Infiltrator Chambers Installed - Blue Lok Filter Installed.

INITIAL SITE SKETCH 1" = 40'

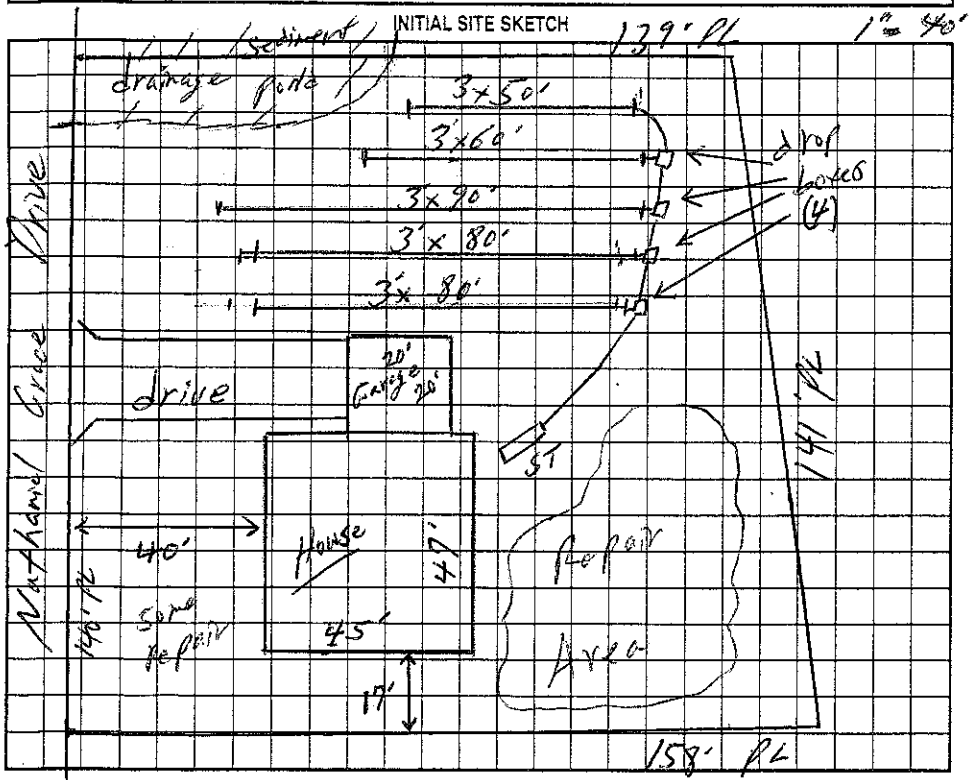

AS BUILT SKETCH 1" = 40'

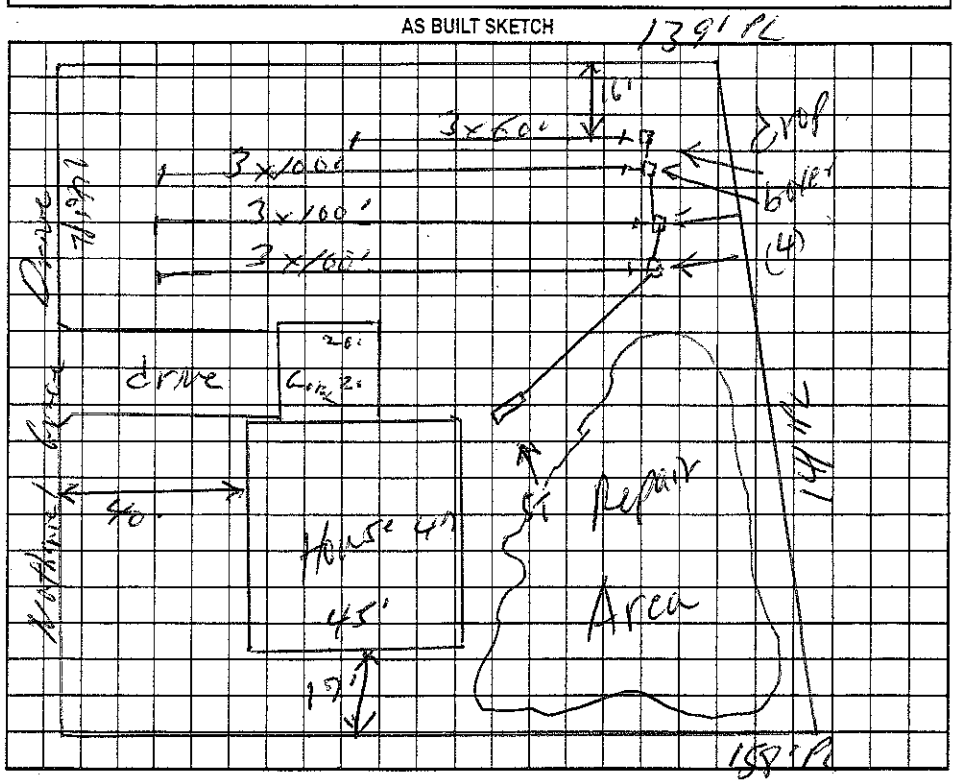

Permit can be suspended or revoked if any false information is supplied toward securing the permit/any unauthorized changes are made to the site/any unauthorized changes are made in the installation of the system. Improvement Permit with plat valid without expiration. Improvement Permit with site plan valid for sixty months. Authorization to Construct is valid for a period equal to that of Improvement Permit – not to exceed sixty months.

Signed: John E. Mullally date —

Improvement Permit by: William O. Johnson date 1/7/04

Authorization to Construct by: William O. Johnson date 1/7/04

Installed by: Rowan Septic

Operation Permit by: William O. Johnson date 6/7/04

Existing System Inspection by: — date —

HEALTH DEPT. COPY: WHITE OWNER COPY (FINAL): YELLOW OWNER COPY (INITIAL): PINK