IREDELL COUNTY HEALTH DEPARTMENT

STATESVILLE 704-878-5305 CJ MOORESVILLE 704-664-5281

CJ

IMPROVEMENT PERMIT / AUTHORIZATION TO CONSTRUCT / OPERATION PERMIT / EXISTING SYSTEM INSPECTION

PERMIT# 112798 PIN# 4726-02-7751 DATE 6/10/03

OWNER OR CONTRACTOR Sonoma Builders PHONE: Business (704) 376-6571 Home

ADDRESS 1655 Scotland Ave Charlotte, N.C. 28207

LOCATION Hwy 115 N (L) Scotts Creek Rd

SUBDIVISION Celtic Ridge BLOCK / SECTION – LOT 14 LOT AREA .459 Ac. SITE CLASS. PS DESIGN FLOW 360 L.T.A.R. .25

Septic Tank: 4000 Gallons; STB 1012 Date 8-11-03
Pump Tank: Gallons; PT Date
Pump Make: Model Serial No.
Nitrification Field: No Fields 1 Square Feet Equiv to 1440 Linear Feet 360
No Lines 4 @ 90' Trench Width 36" Max Trench Bottom Depth 36" Gravel Depth NA

[X] New System [ ] Repair System Type: I, II, (III), IV, V, VI
System Description: Gravity, 25% Reduction
Repair System Description: Pump, 50% Reduction
Maintenance Agreement Required: [ ] Yes [ ] No

[X] House/Mod. Home No. Bedrooms 3
[ ] Mobile Home No. Bathrooms 2
[ ] Business No. Employees
[ ] Other

[ ] Slab [X] Crawl Space [ ] Basement w/plumbing [ ] Basement wo/plumbing


Water Supply: [ ] Individual [X] Public [ ] Community

Comments:/Conditions:


Comments:/Conditions:

– ST marker & Twist Tite Filter Installed
Infiltrator Chambers Installed

INITIAL SITE SKETCH 1" = 40'

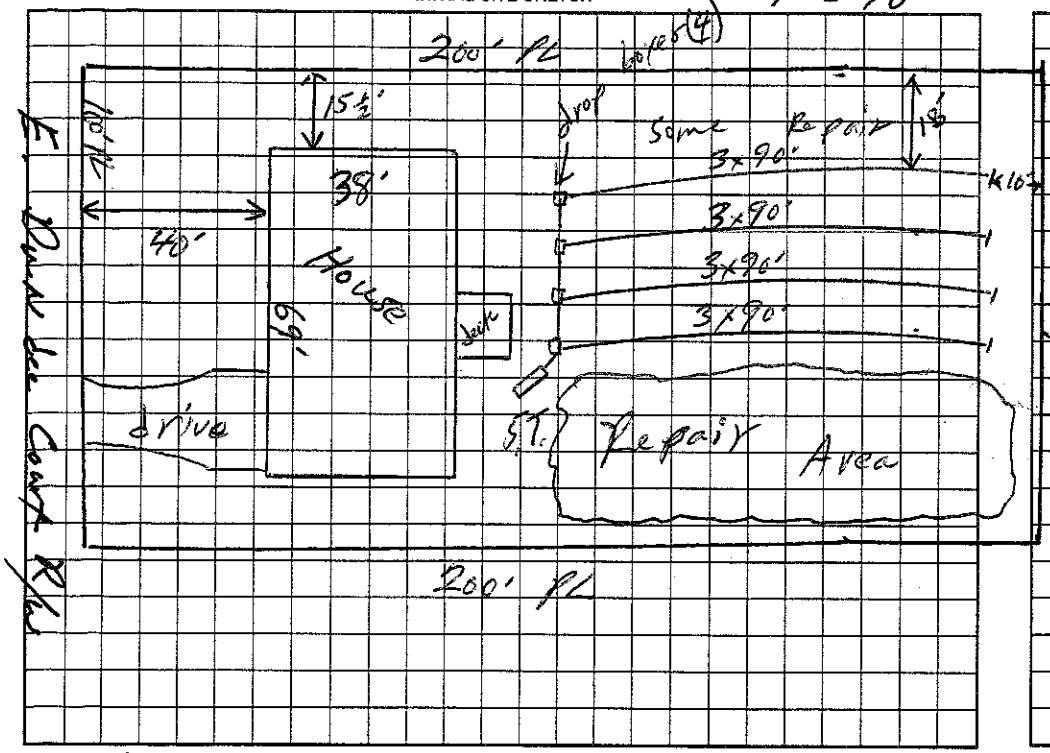

AS BUILT SKETCH

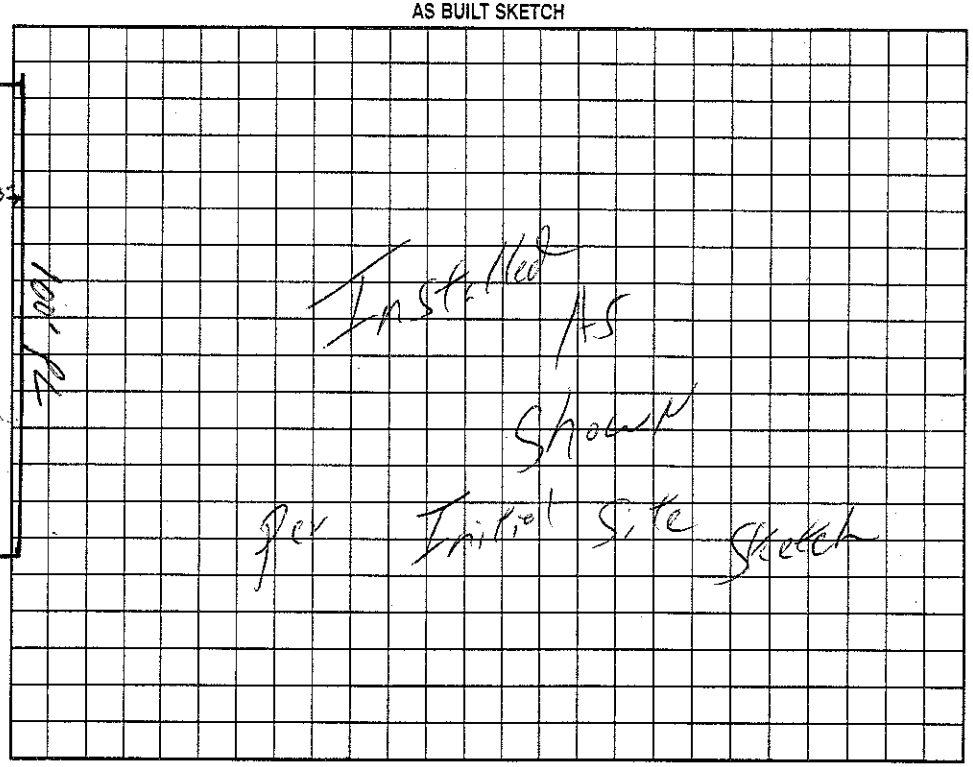

Permit can be suspended or revoked if any false information is supplied toward securing the permit/any unauthorized changes are made to the site/any unauthorized changes are made in the installation of the system. Improvement Permit with plat valid without expiration. Improvement Permit with site plan valid for sixty months. Authorization to Construct is valid for a period equal to that of Improvement Permit – not to exceed sixty months.

Signed: Jim Wilson date 6/12/2003 Installed by: Steve Jordan

Improvement Permit by: William O. Johnson date 6/10/03 Operation Permit by: William O. Johnson date 1/13/04

Authorization to Construct by: William O. Johnson date 6/10/03 Existing System Inspection by: date

HEALTH DEPT. COPY: WHITE OWNER COPY (FINAL): YELLOW OWNER COPY (INITIAL): PINK