IREDELL COUNTY HEALTH DEPARTMENT

STATESVILLE 704-878-5305 CI MOORESVILLE 704-664-5281

IMPROVEMENT PERMIT / AUTHORIZATION TO CONSTRUCT / OPERATION PERMIT / EXISTING SYSTEM INSPECTION

CI

PERMIT# 112799 PIN# 4726-02-7994 DATE 6/4/03

OWNER OR CONTRACTOR Sonoma Builders PHONE: Business (704) 376-6571 Home

ADDRESS 1655 Scotland Ave Charlotte N.C. 28207

LOCATION Hwy 115 N @ Scotts Creek Rd @

SUBDIVISION Celtic Ridge BLOCK / SECTION – LOT 9 LOT AREA .459 Ac. SITE CLASS. PS DESIGN FLOW 360 L.T.A.R.

Septic Tank: 4000 Gallons; STB 1012 Date 7-26-03 ☒ New System ☐ Repair System Type: I, II, (III), IV, V, VI

Pump Tank: Gallons; PT Date

Pump Make: Model Serial No.

Nitrification Field: No Fields 1 Square Feet Req'd 1440 Linear Feet 360

No Lines 4 (Four) Trench Width 36" Max Trench Bottom Depth 30" Gravel Depth NA

System Description: Gravity, 25% Reduction

Repair System Description: Pump 50% Reduction

Maintenance Agreement Required: ☐ Yes ☒ No

☒ House/Mod. Home ☐ Mobile Home ☐ Business ☐ Other

No. Bedrooms 3 No. Bathrooms 2 No. Employees

☐ Slab ☒ Crawl Space ☐ Basement w/plumbing ☐ Basement wo/plumbing


Water Supply: ☐ Individual ☒ Public ☐ Community

Comments:/Conditions: ① Install lines on Contour ② Install Subsurface drain as shown

Comments:/Conditions: ST Marker + Tuff-Tite Filter Installed

360# Inf. Trator chambers Installed

INITIAL SITE SKETCH 1" = 40'

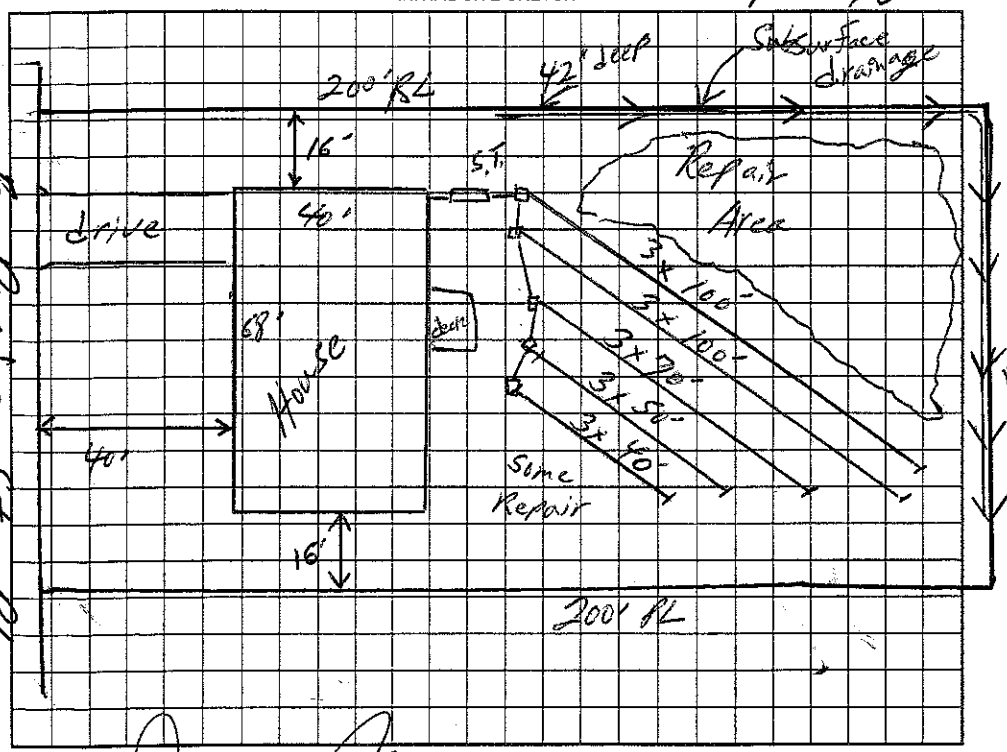

AS BUILT SKETCH

Installed As Shown per Initial Site Sketch

Permit can be suspended or revoked if any false information is supplied toward securing the permit/any unauthorized changes are made to the site/any unauthorized changes are made in the installation of the system. Improvement Permit with plat valid without expiration. Improvement Permit with site plan valid for sixty months. Authorization to Construct is valid for a period equal to that of Improvement Permit – not to exceed sixty months.

Signed: [signature] date 6/12/2003 Installed by: Steve Jordan

Improvement Permit by: William O. Johnson date 6/10/03 Operation Permit by: William O. Johnson date 1/8/04

Authorization to Construct by: William O. Johnson date 6/10/03 Existing System Inspection by: date

HEALTH DEPT. COPY: WHITE OWNER COPY (FINAL): YELLOW OWNER COPY (INITIAL): PINK