IREDELL COUNTY HEALTH DEPARTMENT

STATESVILLE 704-878-5305 (01) MOORESVILLE 704-664-5281

IMPROVEMENT PERMIT / AUTHORIZATION TO CONSTRUCT / OPERATION PERMIT / EXISTING SYSTEM INSPECTION

PERMIT# 120486 PIN# 4726-02-8218 DATE 6/29/04

OWNER OR CONTRACTOR TBJ Properties PHONE: Business (704) 902-4618 Home

ADDRESS 161 Barringer Drive Statesville N.C. 28625

LOCATION Hwy 115 N @ Scotts Creek Rd @ Celtic Ridge (L) on Nathaniel Grace on Right @ Cul-de-Sac

SUBDIVISION Celtic Ridge BLOCK / SECTION LOT 19 LOT AREA 1.787 Acres SITE CLASS. PS DESIGN FLOW 360 L.T.A.R. .30 gpd/ft²

Septic Tank: 1,000 Gallons; STB 1012 Date 2-14-05

Pump Tank: Gallons; PT Date

Pump Make: Model Serial No.

Nitrification Field: No Fields 1 Square Feet Exp/1200 Linear Feet 300

No Lines 4@25 Trench Width 36 Max Trench Bottom Depth 36" Gravel Depth NA

☒ New System ☐ Repair System Type: I, II, (III) IV, V, VI

System Description: Gravity 25% Redmond "LPP" / Gravity 50% Rock

Repair System Description:

Maintenance Agreement Required: ☐ Yes ☒ No

☒ House/Mod. Home No. Bedrooms 3

☐ Mobile Home No. Bathrooms 2

☐ Business No. Employees

☐ Other


☐ Slab ☒ Crawl Space ☐ Basement w/plumbing ☐ Basement wo/plumbing

Water Supply: ☐ Individual ☐ Public ☐ Community


Comments./Conditions:

Comments:/Conditions: (1) SEPTIC TANK WITH RISERS INSTALLED USING "TUFFITE" FILTER (2) SYSTEM ALTERED AS SHOWN WITH PRIOR HEALTH DEPARTMENT APPROVAL

INITIAL SITE SKETCH 1" = 50 ft

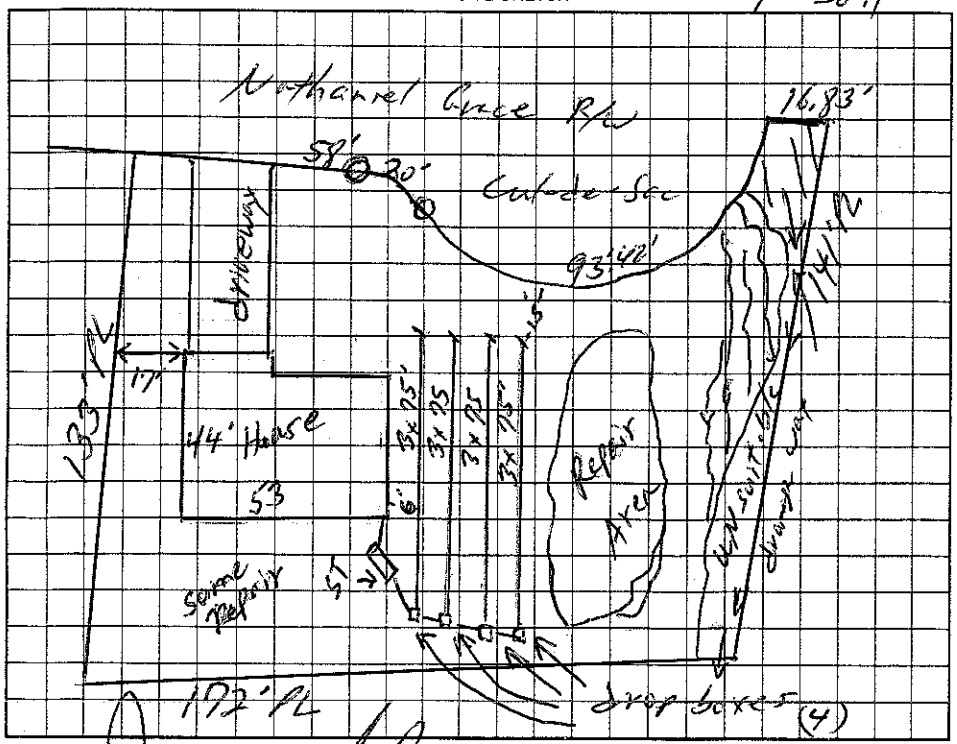

AS BUILT SKETCH

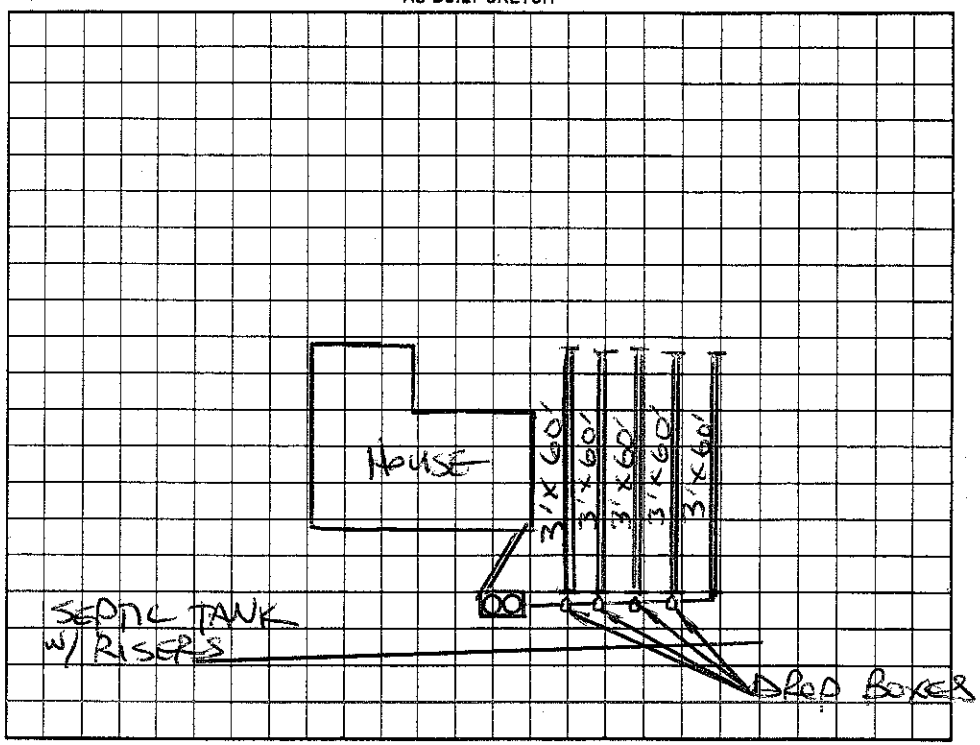

Permit can be suspended or revoked if any false information is supplied toward securing the permit/any unauthorized changes are made to the site/any unauthorized changes are made in the installation of the system. Improvement Permit with plat valid without expiration. Improvement Permit with site plan valid for sixty months. Authorization to Construct is valid for a period equal to that of Improvement Permit – not to exceed sixty months.

Signed: date 7/21/2004 Installed by: PIEDMONT BACKHOE

Improvement Permit by: William O. Johnson date 6/29/04 Operation Permit by: STEVE HENDRICK date 4-5-05

Authorization to Construct by: William O. Johnson date 6/29/04 Existing System Inspection by: date

HEALTH DEPT. COPY: WHITE OWNER COPY (FINAL): YELLOW OWNER COPY (INITIAL): PINK