IREDELL COUNTY HEALTH DEPARTMENT

STATESVILLE 704-878-5305 (c1) MOORESVILLE 704-664-5281

IMPROVEMENT PERMIT / AUTHORIZATION TO CONSTRUCT / OPERATION PERMIT / EXISTING SYSTEM INSPECTION

PERMIT# 120489 PIN# 4726-03-1436 DATE 7/26/04

OWNER OR CONTRACTOR TBJ Properties PHONE: Business (704) 902-4618 Home

ADDRESS 161 Barrington Drive Statesville NC 28625

LOCATION Hwy 115 N @ Celtic Ridge @ W Edinburg Court @ end @ cul-de-sac

SUBDIVISION Celtic Ridge BLOCK / SECTION LOT 35 LOT AREA .479 Ac SITE CLASS. #5 DESIGN FLOW 360 L.T.A.R. .25 gpd/Ac

Septic Tank: 1000 Gallons; STB 1017 Date 5-23-04
Pump Tank: 1000 Gallons; PT 17 Date 11-6-04
Pump Make: Model Serial No.
Nitrification Field: No. Fields 1 Square Feet Eq to 1440 Linear Feet 240
No. Lines 6@40' Trench Width 2FT Max Trench Bottom Depth 36" ~~Gravel~~ Sand Depth 6"

☒ New System ☐ Repair System Type: I, II, (III), IV, V, VI
System Description: Pump/Panel
Repair System Description: LP Panel
Maintenance Agreement Required: ☐ Yes ☒ No

☒ House/Mod. Home No. Bedrooms 3
☐ Mobile Home No. Bathrooms 2
☐ Business No. Employees
☐ Other


☐ Slab ☒ Crawl Space ☐ Basement w/plumbing ☐ Basement wo/plumbing

Water Supply: ☐ Individual ☒ Public ☐ Community

Comments/Conditions: ① Install 54 Panels with 40 tons of Sand (8FT on center)

Comments/Conditions: TUFF TITE FILTER FABRIC V'N LINES & TANKS ON 3-31-05 LC

INITIAL SITE SKETCH

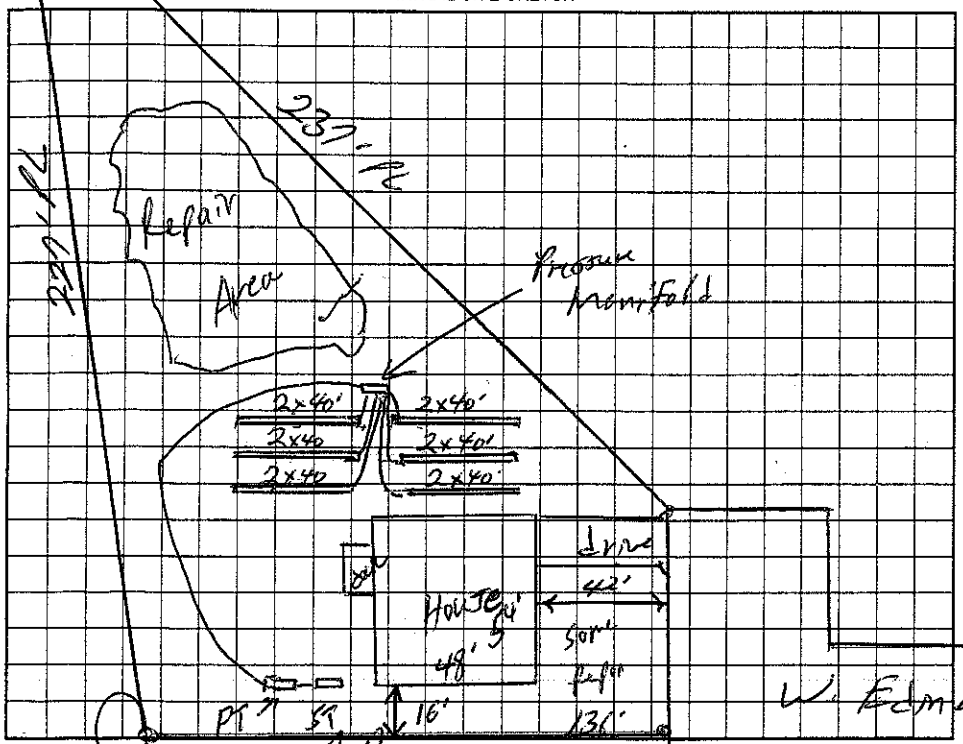

AS BUILT SKETCH

SYSTEM INSTALLED ACCORDING TO INITAL SITE SKETCH

Permit can be suspended or revoked if any false information is supplied toward securing the permit/any unauthorized changes are made to the site/any unauthorized changes are made in the installation of the system. Improvement Permit with plat valid without expiration. Improvement Permit with site plan valid for sixty months. Authorization to Construct is valid for a period equal to that of Improvement Permit – not to exceed sixty months.

Signed: date 7/26/2004 Installed by: STEVE JORDAN

Improvement Permit by: date 7/26/04 Operation Permit by: STEVE HENDRICK date 10-11-05

Authorization to Construct by: date 7/26/04 Existing System Inspection by: date

HEALTH DEPT. COPY: WHITE OWNER COPY (FINAL): YELLOW OWNER COPY (INITIAL): PINK