IREDELL COUNTY HEALTH DEPARTMENT

STATESVILLE 704-878-5305 MOORESVILLE 704-664-5281

IMPROVEMENT PERMIT / CERTIFICATE OF COMPLETION / OPERATION PERMIT / EXISTING SYSTEM INSPECTION

PROPERTY DESCRIPTION NO. 17154 DATE 10/6/93 TAX MAP NO. 9D-A-8

OWNER OR CONTRACTOR CLEVELAND LAZENBY PHONE: Business Home 873-5450

ADDRESS Rt. 13, Box 290 STVL, NC 28677

LOCATION NC 115 N, TL SCOTTS CREEK RD, ON (R) ~ 2.5 MILE JUST BEFORE LITTLE FARM RD.

SUBDIVISION BLOCK / SECTION LOT LOT AREA 80 X 330' SITE CLASS. PS L.T.A.R. EXISTING

Water Supply: ☑ Individual ☐ Community ☐ Public WELL

Septic Tank: 1000 Gallons: STB 358 Date 8/18/93

Pump Tank: Gallons: PT Date

Nitrification Field: No Fields Square Feet Linear Feet

No Lines Trench Width Trench Depth Gravel Depth

☐ New System ☑ Repair System Type: I, II, III, IV, V, VI

System Description: CONV. GRAVITY

Repair System Description:

Maintenance Agreement Required: ☐ Yes ☑ No

☑ House/Mod. Home No. Bedrooms 3 Garbage Disposal: ☐ Yes ☑ No

☐ Mobile Home No. Bathrooms 2 Auto. Dishwasher: ☐ Yes ☐ No


☐ Business No. Employees Auto. Washing Machine: ☑ Yes ☐ No

☐ Other ADDITION OF PATIO Other

☐ Slab ☑ Crawl Space ☐ Basement w/plumbing ☐ Basement wo/plumbing

Comments (1) ABANDON EXISTING S.T. PUMP OUT & FILL W/DIRT. (2) INSTALL NEW S.T. AT LOCATION SHOWN (3) TIE INTO EXISNG DRAINFIELD USING NEW D. BOX AS SHOWN.

INITIAL SITE SKETCH

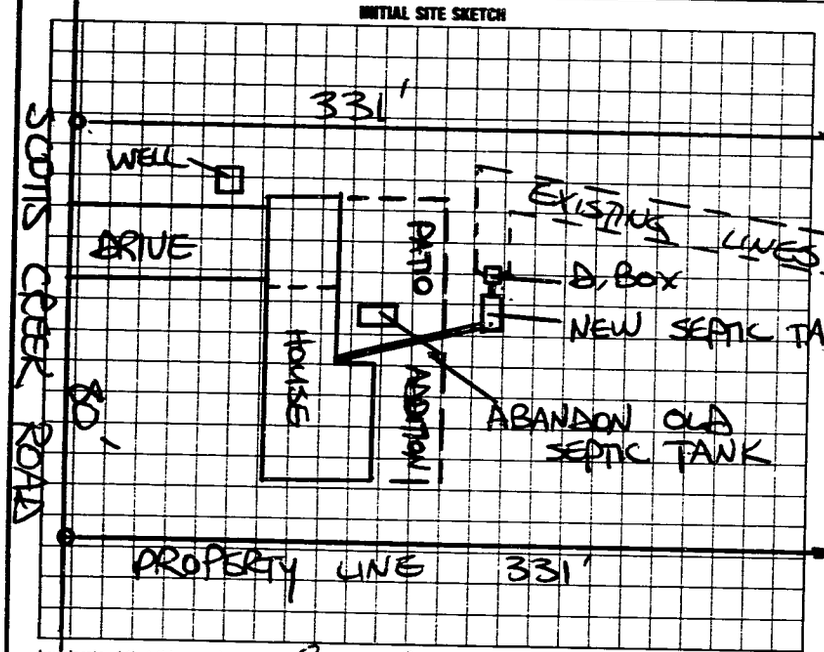

AS BUILT SKETCH

SEPTIC TANK INSTALLED ACCORDING TO INITAL SITE SKETCH

I understand that this permit can be suspended or revoked if any false information is supplied toward securing the permit/any unauthorized changes are made to the site/any unauthorized changes are made in the installation of the system. Improvement Permit is valid for 60 months from date of issuance.

Signed: Cleveland Lazenby

Improvement Permit by: STEVE HEDRICK date 10/6/93

Existing System Inspection by: date

Installed by: DONALD LACKEY

Certificate of Completion by: STEVE HEDRICK date 10/19/93

Operation Permit by: date

HEALTH DEPT. COPY: WHITE INSPECTION COPY (FINAL): GREEN OWNER COPY (FINAL): YELLOW INSPECTION COPY (INITIAL): PINK OWNER COPY (INITIAL): GOLD