IREDELL COUNTY HEALTH DEPARTMENT

STATESVILLE 704-878-5305 (C1) MOORESVILLE 704-664-5281

IMPROVEMENT PERMIT / AUTHORIZATION TO CONSTRUCT / OPERATION PERMIT / EXISTING SYSTEM INSPECTION

PERMIT# 126321 PIN# 4726-03-3272 DATE 3-23-05

OWNER OR CONTRACTOR TBJ PROPERTIES, LLC PHONE: Business 704-902-4618 Home 704-876-1984

ADDRESS 413 MILLER FARM ROAD, STATESVILLE, NC 28625

LOCATION NC 115 NORTH TL SCOTTS CREEK RD, TL CELTIC RIDGE DR, TR W. EDINBURGH CT, 3RD LOT ON LEFT

SUBDIVISION CELTIC RIDGE BLOCK / SECTION ____ LOT 32 LOT AREA 0.459 ACRE SITE CLASS PS DESIGN FLOW 360 L.T.A.R. 0.25 GPD/FT2

Septic Tank: 1000 Gallons; STB 1012 Date 12-7-04

Pump Tank: ____ Gallons; PT ____ Date ____

Pump Make: ____ Model ____ Serial No. ____

Nitrification Field: No Fields 1 Square Feet 1440 Linear Feet 360

No Lines FIVE Trench Width 36" Max Trench Bottom Depth 36" Gravel Depth N/A

☑ New System ☐ Repair System Type: I, II, (III), IV, V, VI

System Description: 25% REDUCTION, GRAVITY

Repair System Description: 50% REDUCTION, LOW-PRESSURE

Maintenance Agreement Required: ☐ Yes ☑ No

☑ House/Mod. Home No. Bedrooms 3

☐ Mobile Home No. Bathrooms ____

☐ Business No. Employees ____

☐ Other ____


☐ Slab ☑ Crawl Space ☐ Basement w/plumbing ☐ Basement wo/plumbing

Water Supply: ☐ Individual ☑ Public ☐ Community


Comments:/Conditions: INSTALL 25% REDUCTION SYSTEM ON CONTOUR

Comments:/Conditions: SEPTIC TANK WITH MARKER INSTALLED USING "TUFFITE" FILLER

INITIAL SITE SKETCH

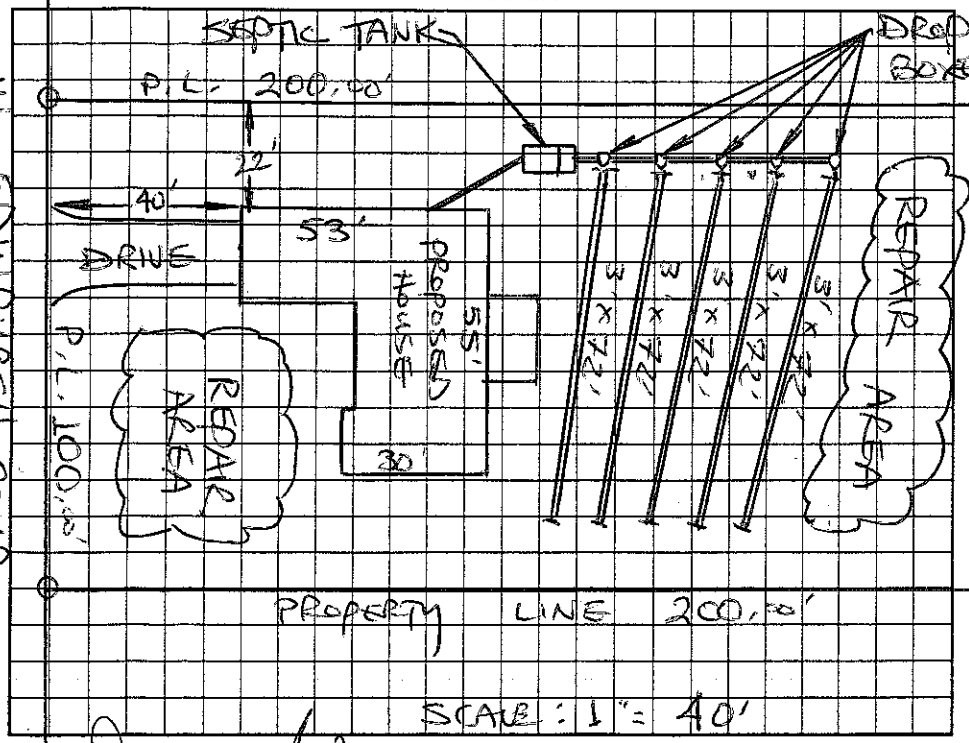

AS BUILT SKETCH

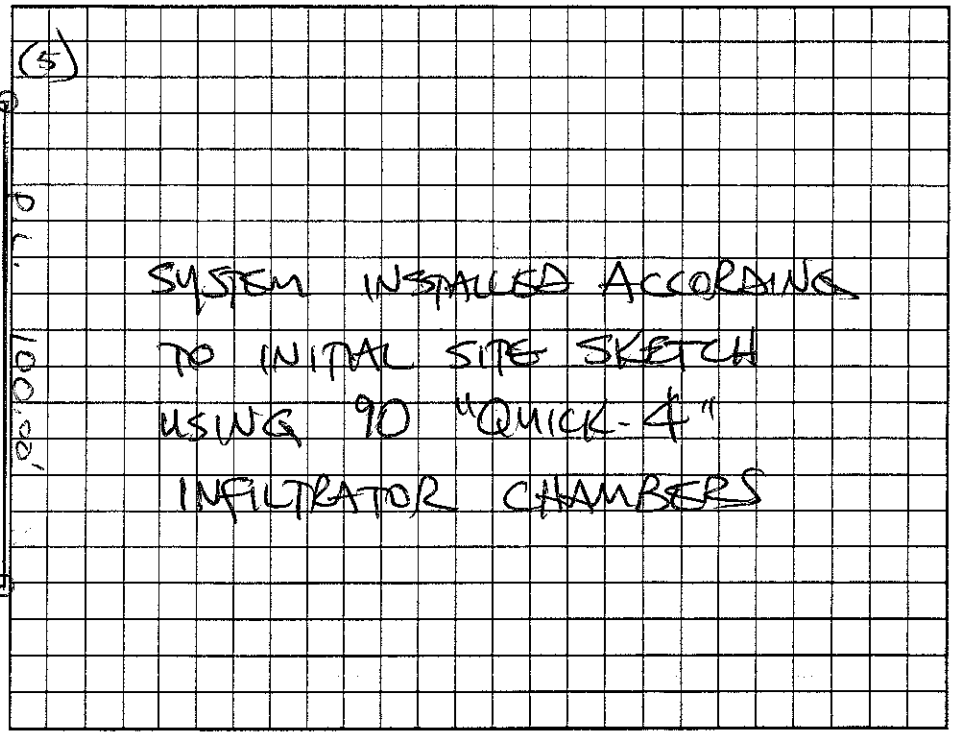

Permit can be suspended or revoked if any false information is supplied toward securing the permit/any unauthorized changes are made to the site/any unauthorized changes are made in the installation of the system. Improvement Permit with plat valid without expiration. Improvement Permit with site plan valid for sixty months. Authorization to Construct is valid for a period equal to that of Improvement Permit – not to exceed sixty months.

Signed: ____ date 3-23-05 Installed by: PIEDMONT SEPTIC

Improvement Permit by: STEVE HEDRICK date 3-23-05 Operation Permit by: STEVE HEDRICK date 8-16-05

Authorization to Construct by: STEVE HEDRICK date 3-23-05 Existing System Inspection by: ____ date ____

HEALTH DEPT. COPY: WHITE OWNER COPY (FINAL): YELLOW OWNER COPY (INITIAL): PINK